

Richard Perry

WATER SERVICE RECORD

Name Leeland Construction Co., Inc.

Service No. 63

Address 16 Ellison Road

Location

~~Repair or Renewal~~ - New Service

Com. 6-1-54


Date	Material	Amount	Total	Date	Amount
4/21/54	Labor	1 85		3-31-54	Deposited 25 00
	10% Overhead	19	2 04	6-1-54	Refunded 4 21
	40' - 3/4" Copper Tubing @ .35		14 00		NON CHARGE 20 79
	1 - 3/4" C x 1/2" I.W.H. stop & waste		4 00	4/21/54	Labor 5 27
	1 hr. trucking		75		10' - 3/4" Copper tubing @ .35 3 50
			20 79		1 - 3/4" C. curb-cock 4 33
	TRENCH DUG BY OWNER				1 - 3/4" C x 3/4" C. curb-cock 4 67
					1 box and rod 3 90
					1 - 1/2" straight tail piece 50
					1 - 1/2" offset tail piece 50
					1 hr. trucking 75
					23 42

DATE _____

TOWN OF LEXINGTON — BOARD OF PUBLIC WORKS

WATER DIVISION

Sketch of Service Here

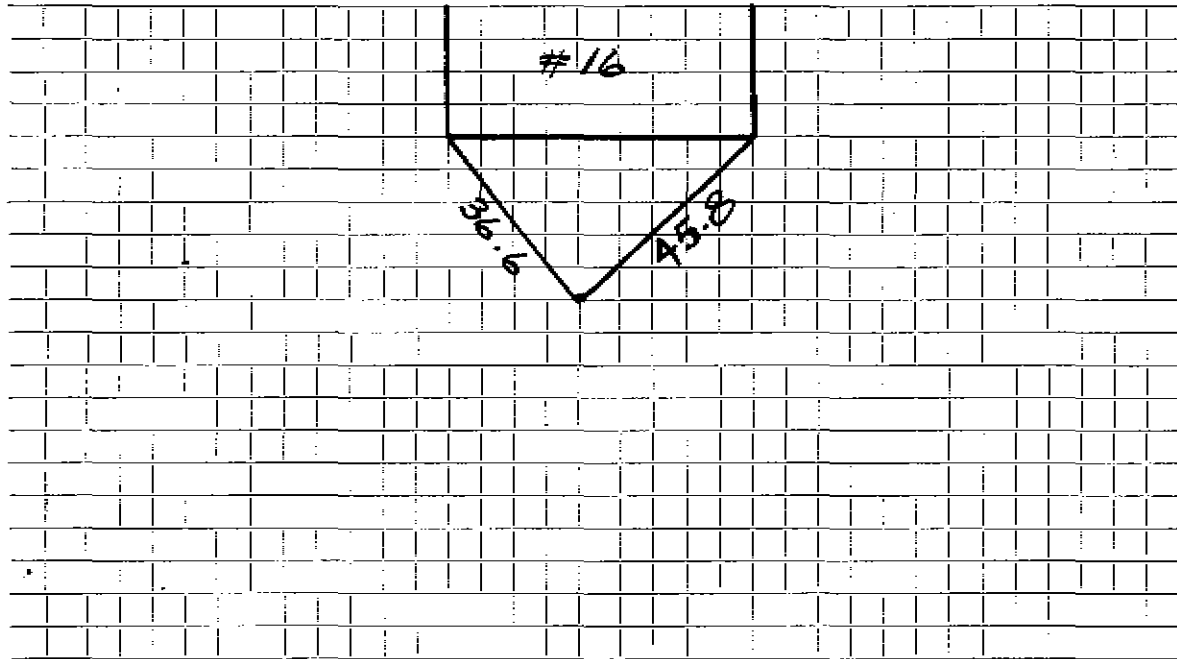

Connection made in Street. Work completed

Remarks:

.....

.....