

WATER SERVICE RECORD

Name Leeland Construction Co., Inc.

Service No. 64

Address 17 Ellison Road

Location

~~Repair - Rework~~ - New Service

Conn 6-1-54


Date	Material	Amount	Total	Date	Amount
4/27/54	Labor	1 85		3-31-54 Deposited	25 00
	10% Overhead	19	2 04	6-1-54 Refunded	4 21
	40' - 3/4" Copper tubing @ .35	14 00		NON CHARGE	20 79
	1 - 3/4" Cx 3/4" I.W.H. stop & waste	4 00	4 00	4/27/54 Labor	5 10
	1 hr. trucking		75	25' - 3/4" Copper tubing @ .35	8 75
	NON CHARGE		20 79	1 - 3/4" C. corp-cock	4 33
9-11-58	Labor			1 - 3/4" C.x3/4" C. curb-cock	4 67
	10' 3/4" Copper Tubing			1 Box & Rod	3 90
	1 3/4" Style 88 Coupling			1 - 1/2 straight tail piece	50
	1 HR Trucking			1 - 1/2 offset tail piece	50
				1 hr. trucking	75
					28 50
	TRENCH DUG BY OWNER				

DATE _____

TOWN OF LEXINGTON — BOARD OF PUBLIC WORKS

WATER DIVISION

Sketch of Service Here

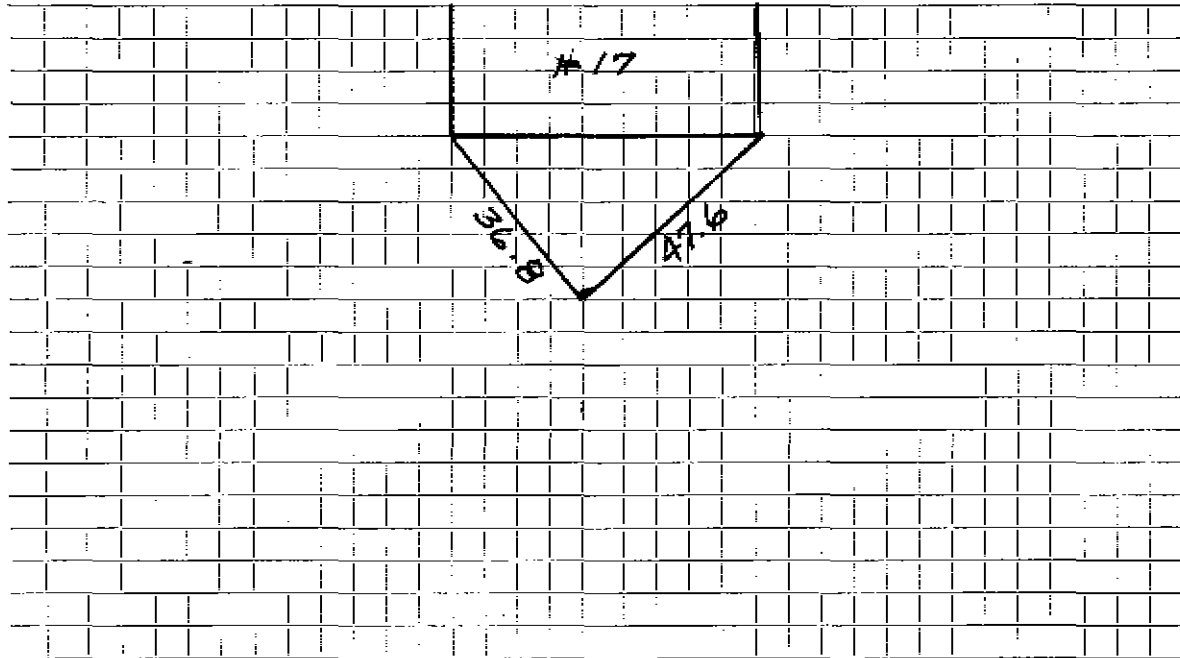

Connection made in Street. Work completed

Remarks:

.....

.....