

WATER SERVICE RECORD

Name Leeland Construction Co., Inc. Service No. 85
 Address 18 Ellison Road #4004
 Location _____
~~Repair or Replacement~~ New Service *Com. 6-1-54*


Date	Material	Amount	Total	Date	Amount
4/22/54	Labor	1 85		4-22-54	Deposited 25 00
	10% Overhead	19	2 04	6-1-54	Refunded 4 21
	40' 3/4" Copper tubing @ .35	14 00			<u>NON CHARGE</u> 20 79
	1 - 3/4" C. x 1/2" I.W.H. stop & waste	4.00	4/22/54	Labor	1 85
	1 hr. trucking		75	10' 3/4" Copper tubing @ .35	3 50
			20 79	1 - 3/4" C. Corp-cock	4 33
				1 - 3/4" C x 3/4" C. curb-cock	4 67
				1 Box & Rod	3 90
				1 - 1/2" offset tail piece	50
				1 - 1/2" straight tail piece	50
				1 hr. trucking	75
					<u>20 00</u>
	TRENCH DUG BY OWNER				

DATE _____

TOWN OF LEXINGTON — BOARD OF PUBLIC WORKS

WATER DIVISION

Sketch of Service Here

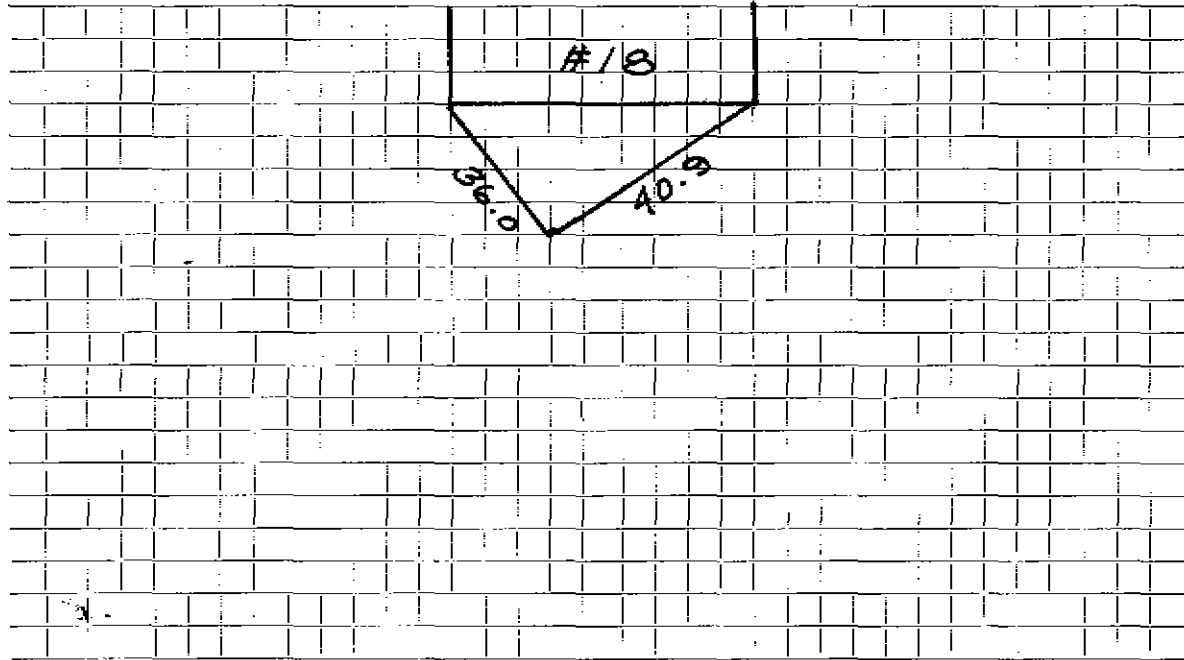

Connection made in Street. Work completed

Remarks:

.....

.....