

WATER SERVICE RECORD

Name Leeland Construction Co., Inc.

Service No. 86

Address 19 Ellison Road

Location

Service Renewal - New Service

Com 6-1-54


Date	Material	Amount	Total	Date	Amount
5/13/54	Labor	1 85		4-22-54 6-1-54	25.00 4 21
	10% Overhead	19	2 04		NON CHARGE
	40' 3/4" Copper tubing @ .35	14 00	5/13/54	Labor	5 27
	1 - 3/4" Cx 1/2 I.W. H. stop & waste	4 00	25' 3/4" Copper tubing @ .35		8 75
	1 hr. trucking		75	1 - 3/4" C. Corp-cock	4 33
			20 79	1 - 3/4" Cx 3/4" C. curb-cock	4 67
				1 Box & Rod	3 90
				1 - 1/2 straight tail piece	50
				1 - 1/2 offset tail piece	50
				1 hr. trucking	75
	TRENCH DUG BY OWNER				28 67
	NON CHARGE				
9-9-58	Labor				
	2 3/4" Style 88 Coupling				
	8' 3/4 Copper Tubing				
	1 Hr. Trucking				

DATE _____

TOWN OF LEXINGTON — BOARD OF PUBLIC WORKS

WATER DIVISION

Sketch of Service Here

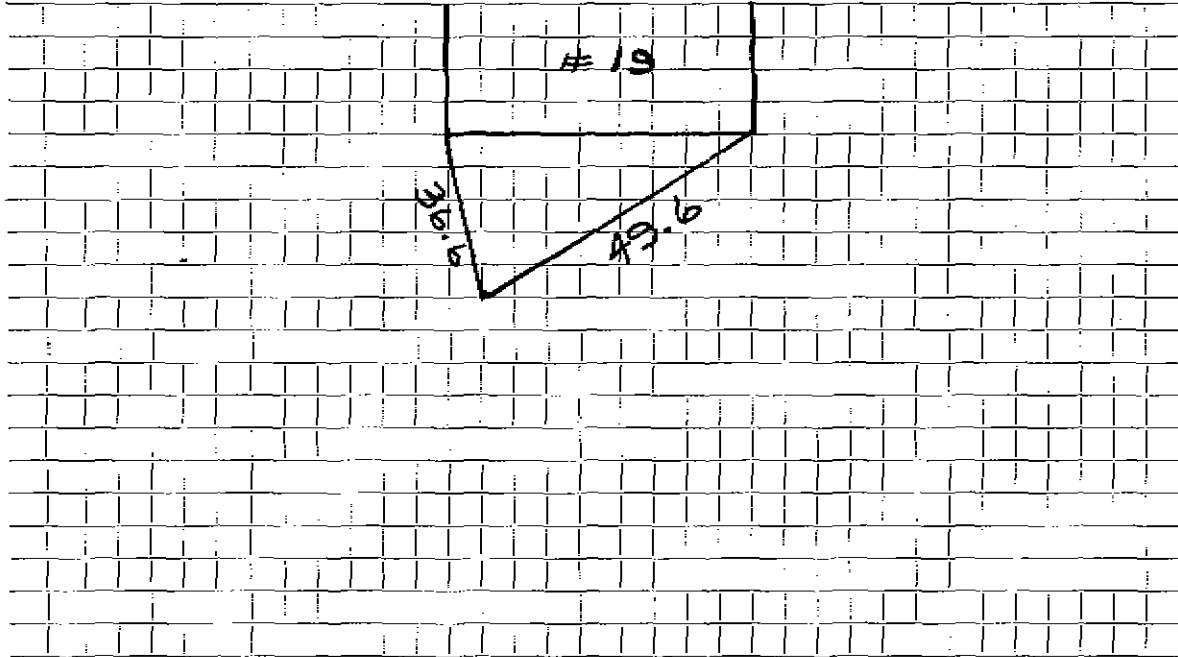

Connection made in : Street. Work completed

Remarks:

.....

.....