

WATER SERVICE RECORD

Name Leeland Construction Co., Inc.

Service No. 87 #20

Address 20 Ellison Road

Location

~~Repair to Runcock~~ - New Service

Com. 6-1-54


Date	Material	Amount	Total	Date	Amount
4/22/54	Labor	1 85		4-22-54	Deposited 25 00
	10% Overhead	19	2 04	6-1-54	Refunded 4 21
	40' 3/4" Copper tubing @ .35	14 00			NON CHARGE 20 79
	1 - 3/4" Cx 1/2 I.W.H. stop & waste	4 00	4 00	4/22/54	Labor 1 85
	1 hr. trucking		75		10' 3/4" Copper tubing @ .35 3 50
			20 79		1 - 3/4" C. corp-cock 4 33
					1 - 3/4" Cx 3/4" C curb-cock 4 67
	TRENCH DUG BY OWNER				1 Box & rod 3 90
					1 - 1/2 straight tail piece 50
					1 - 1/2 offset tail piece 50
					1 hr. trucking 75
					20 00

DATE _____

TOWN OF LEXINGTON — BOARD OF PUBLIC WORKS

WATER DIVISION

Sketch of Service Here

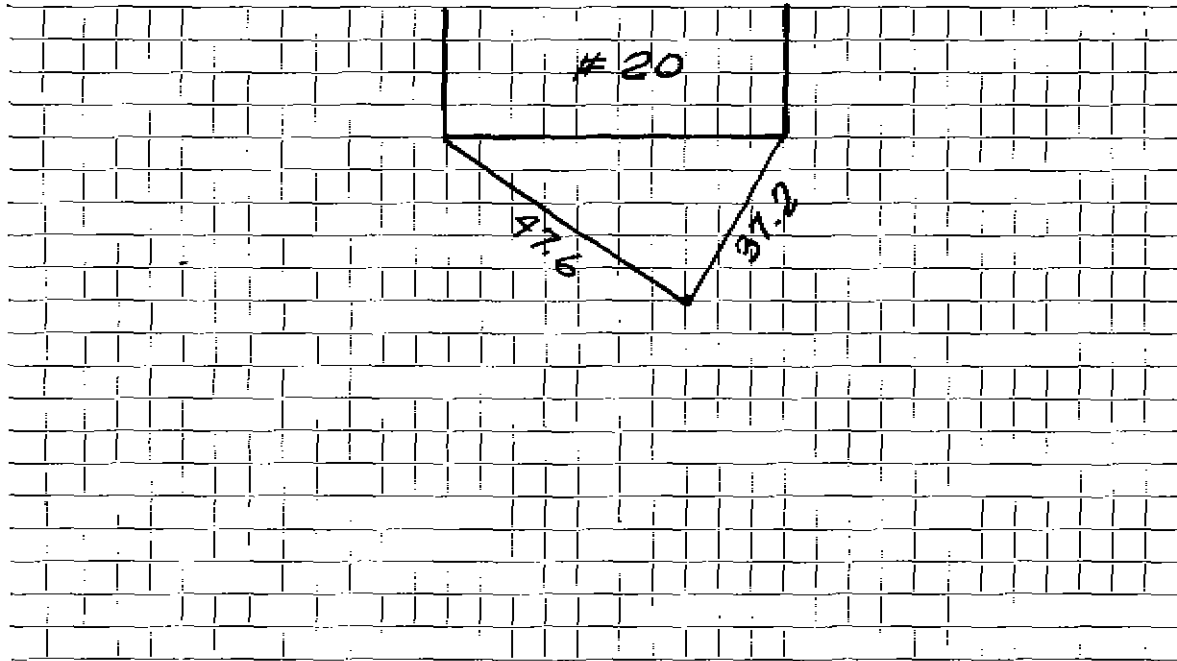

Connection made in Street. Work completed

Remarks:
.....
.....