


DATE _____

TOWN OF LEXINGTON — BOARD OF PUBLIC WORKS
WATER DIVISION

Sketch of Service Here

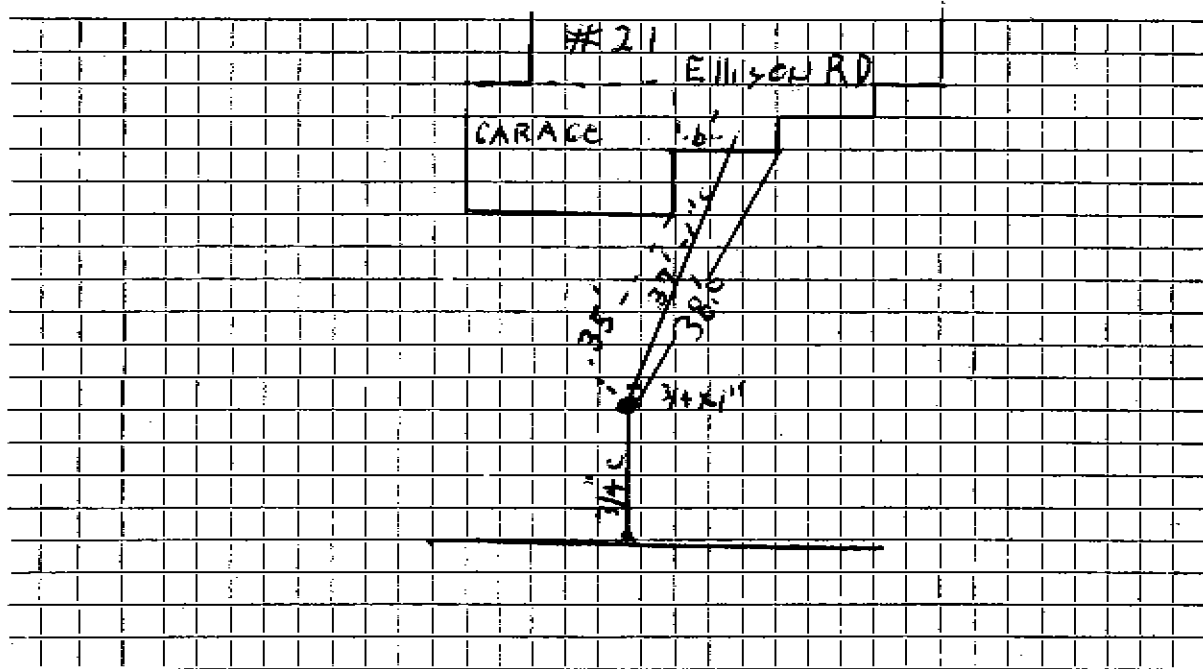

Connection made in Street.

Work completed 5/19/04 J. McI.

Remarks:
.....
.....