

WATER SERVICE RECORD

Name Bob Innis, Inc.

Service No. 116

Address 3 Ellison Road

Location Lexington

~~Repair~~ ~~Renewal~~ - New Service COM. 9/8/52


Date	Material	Amount	Total	Date	Amount
7/26/52	Labor	1 63		6-25-52	Deposited 40 00
	10% overhead	16	1 79	9-10-52	Refunded & credited 17 16
	50' - 3/4" copper tubing@.326		16 30	to bal. Susan in NC # 188 9#189	NON CHARGE 22 84
	1 - 3/4" C x 1/2 I.W.H. stop & waste		4 00	7/26/52	Labor 3 67
	1 hr. trucking		75	27' - 3/4" copper tubing@.326	8 80
			22 84	1 - 3/4" c. corp-cock	4 33
				1 - 3/4" C x 3/4" C. curb-cock	4 67
				1 - 3/4" C x 3/4" C. union 3 pts.	1 72
				1 box and rod	4 68
				1 - 1/2 straight tail piece	50
				1 - 1/2 offset tail piece	50
				1 hr. Littlefield shovel	7 00
				1 hr. trucking	75
9-15-58	Labor				36 62
	8' 3/4" Copper Tubing				
	1 3/4" C Curb Cock				
	1 3/4" Style 88 Coupling				
	1 3/4" C 3 pt union				
	1 Hr. Trucking				

DATE _____

TOWN OF LEXINGTON — BOARD OF PUBLIC WORKS

WATER DIVISION

Sketch of Service Here

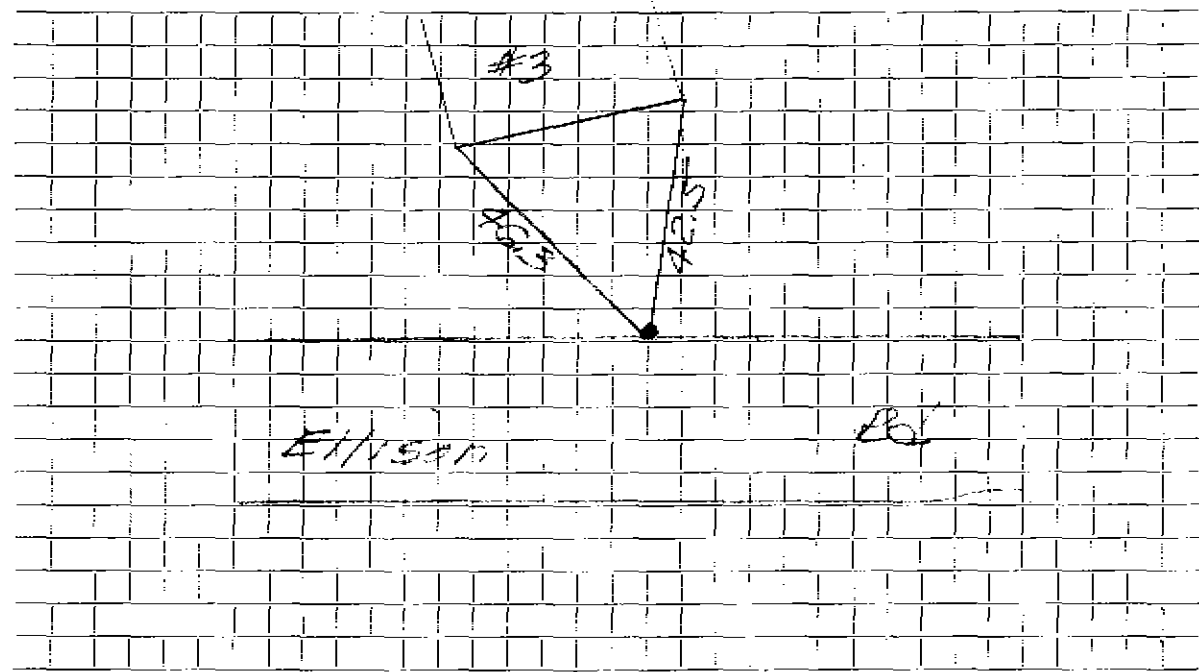

Connection made in Street. Work completed

Remarks:
.....
.....