

WATER SERVICE RECORD

Name Bob Innis, Inc.

Service No. 188

Address 4 Ellison Road

Location Lexington

Repair ~~Renewal~~ - New Service COM. 9/8/52


Date	Material	Amount	Total	Date	Amount
7/26/52	Labor	4 40			
	10% overhead	44	4 84	9-8-52	34 61
	50' - 3/4" copper tubing @ .326		16 30		<u>NON CHARGE</u>
	1 - 3/4" C x 3/4" I.W.H. stop & waste		4 00	7/26/52	Labor
	1 - 3/4" C x 3/4" Union 3 pts.		1 72		15' - 3/4" copper tubing @ .326
	1 hr. littlefield shovel		7 00		1 - 3/4" C. corp-cock
	1 hr. trucking		75		1 - 3/4" C x 3/4" C. curb-cock
			34 61		1 - box and rod
9-23-60	Labor	2 25			1 - 1/2 offset tail piece
	10% O.H.	.23			1 - straight tail piece
	6' 3/4" Copper Tubing @ .42				1 - hr. Littlefield shovel
	2 3/4" C 3 pt union @	2.41			1 hr. trucking
	1 Box of Rod				
	1 Hr. Trucking @ 3.00				
					31 75

DATE _____

TOWN OF LEXINGTON — BOARD OF PUBLIC WORKS

WATER DIVISION

Sketch of Service Here

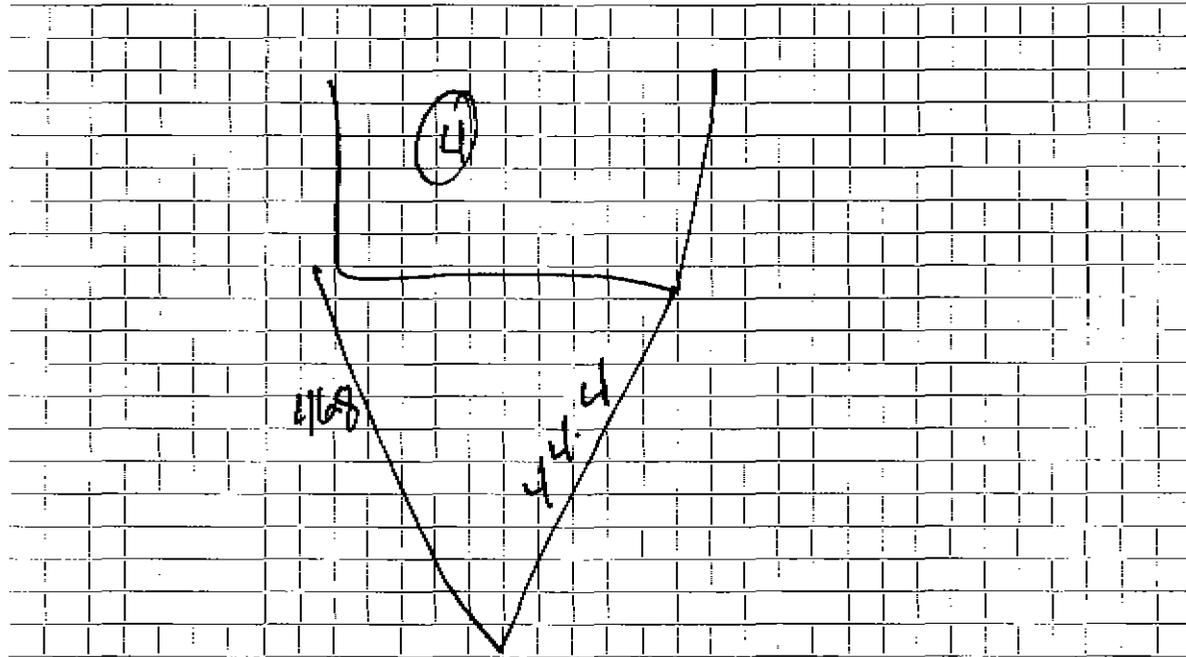

Connection made in Street. Work completed

Remarks:

.....

.....