

Name

Service No. 814

Address

Location 11 Elm Ave.

Now HARRINGTON RD

Kind of Pipe

Size

Size of Main

Repair—Renewal—New Service

Location

Date

Material

Amount

Total

Date

Amount

Labor

DATE \_\_\_\_\_

**TOWN OF LEXINGTON—BOARD OF PUBLIC WORKS**  
**WATER DIVISION**

The undersigned applies for a supply of water at No. \_\_\_\_\_ St. and hereby agrees to comply with the rules and regulations as now, or at any future time, established by the Board of Selectmen.

Am't. of Estimate \$ \_\_\_\_\_

Owner

Dr. Tilton


Am't. Paid \$ \_\_\_\_\_

Address

11 Elm Ave.

Builder \_\_\_\_\_

Sketch of Service Here

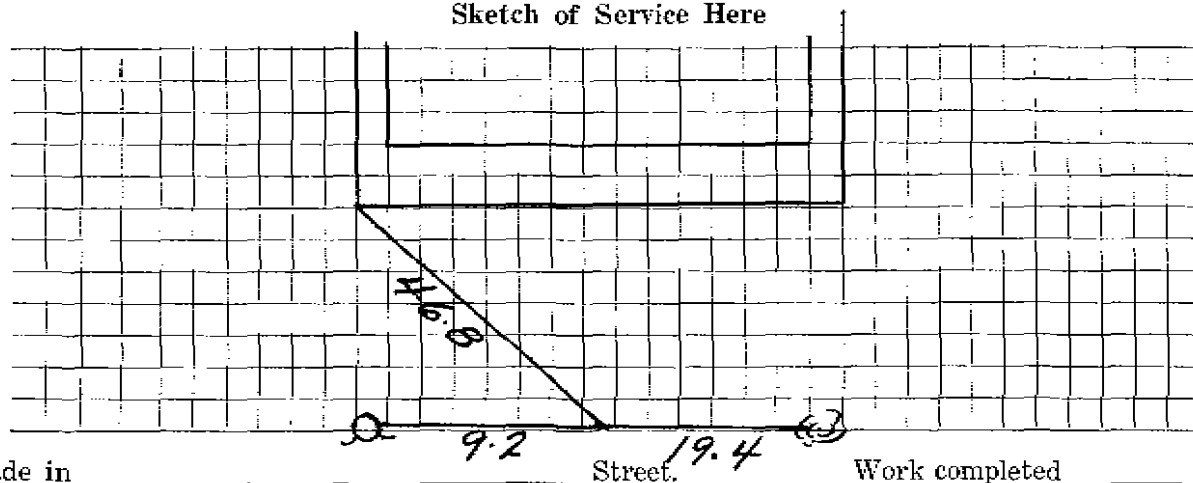

Connection made in \_\_\_\_\_

Street.

Work completed \_\_\_\_\_

19 \_\_\_\_\_

Remarks: