

## WATER SERVICE RECORD

Name Mark Moore

Service No. 292

Address 43 Ridge AvenueLocation 121 Emerson Road

Repair/Renewal New Service


Comm 2-8-66

Date	Material	Amount	Total	Date	Amount
11-23-59	Labor	1.95		11-4-59	Deposit
	10% O.H.	.20	2.15	2-8-66	Paid by S.H.C. 224
43'	3/4" Copper tubing @ .42		18.06		
1	3/4" Cx $\frac{1}{2}$ I.W.H. Stop & Waste	5.88			
1	Hr. Trucking @ .75	.75			NON CHARGE
			26.84		Labor
				11	3/4" Copper tubing @ .42
					4.62
				1	3/4" C Corp Cock
					5.98
				1	3/4" C Curb Cock
					4.67
				1	Box & Rod
					5.00
				1	1 $\frac{1}{2}$ Straight tailpiece
					.50
				1	1 $\frac{1}{2}$ Offset tailpiece
					.50
					22.88

DATE \_\_\_\_\_

TOWN OF LEXINGTON — BOARD OF PUBLIC WORKS  
WATER DIVISION

Sketch of Service Here

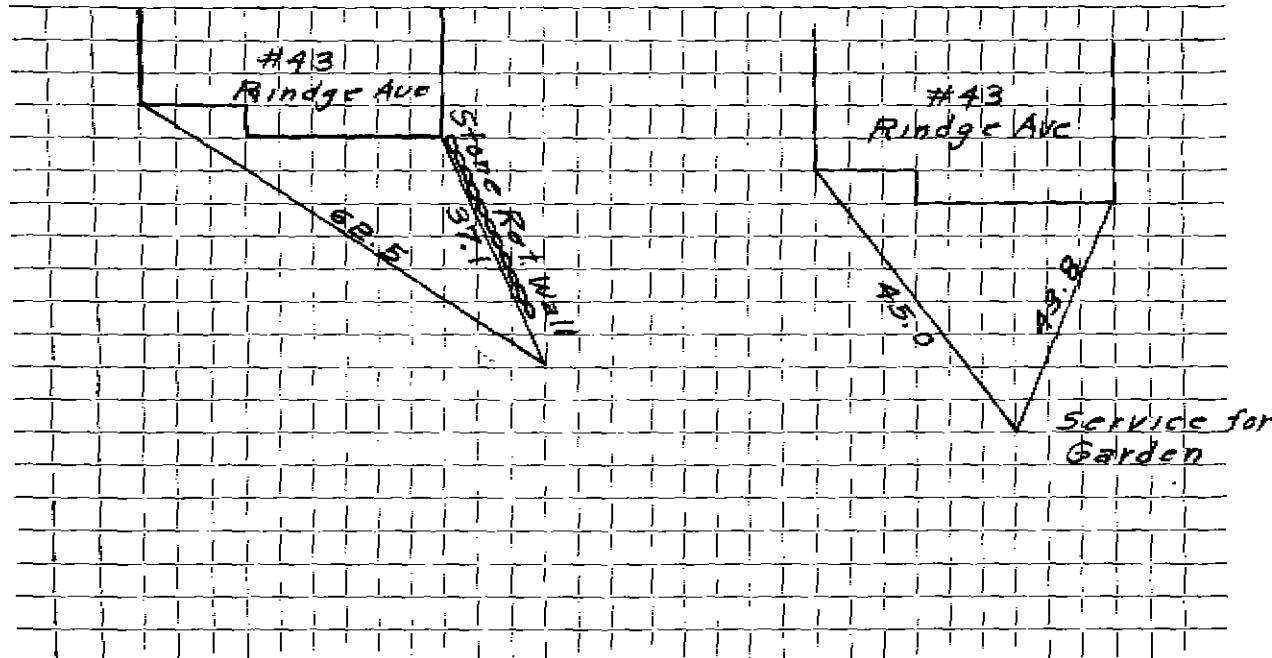

Connection made in ..... Street. Work completed .....

Remarks: .....

.....

.....