

WATER SERVICE RECORD

Name Richard D. Hamilton

Service No. 19

Address 19 Emerald Street Mail: 14 Harbell St. - Lexington

Location

~~Repair - Renewal~~ New Service

Comm 5-15-60


Date	Material	Amount	Total	Date	Amount
4-8-60	Labor	1 94		3-29-60	Deposit 50 00
	10% O.H.	19	2 13	5-16-60	Retard 28 35
	30' 3/4" Copper tubing @12		12 60		21 65
	1 3/4" Cx1/2 IWH Stop & Waste	6	17		<u>NON CHARGE</u>
	1 Hr Trucking @75		75		Labor 1 88
			21 65		15' 3/4" Copper tubing @12 30
					1 3/4" C Corp. Cock 4 91
					1 3/4" C Curb Cock 6 28
					1 Box & Rod 5 00
					1 1/2 Straight tailpiece 50
					1 1/2 Offset tailpiece 50
					25 37

DATE _____

TOWN OF LEXINGTON — BOARD OF PUBLIC WORKS

WATER DIVISION

Sketch of Service Here

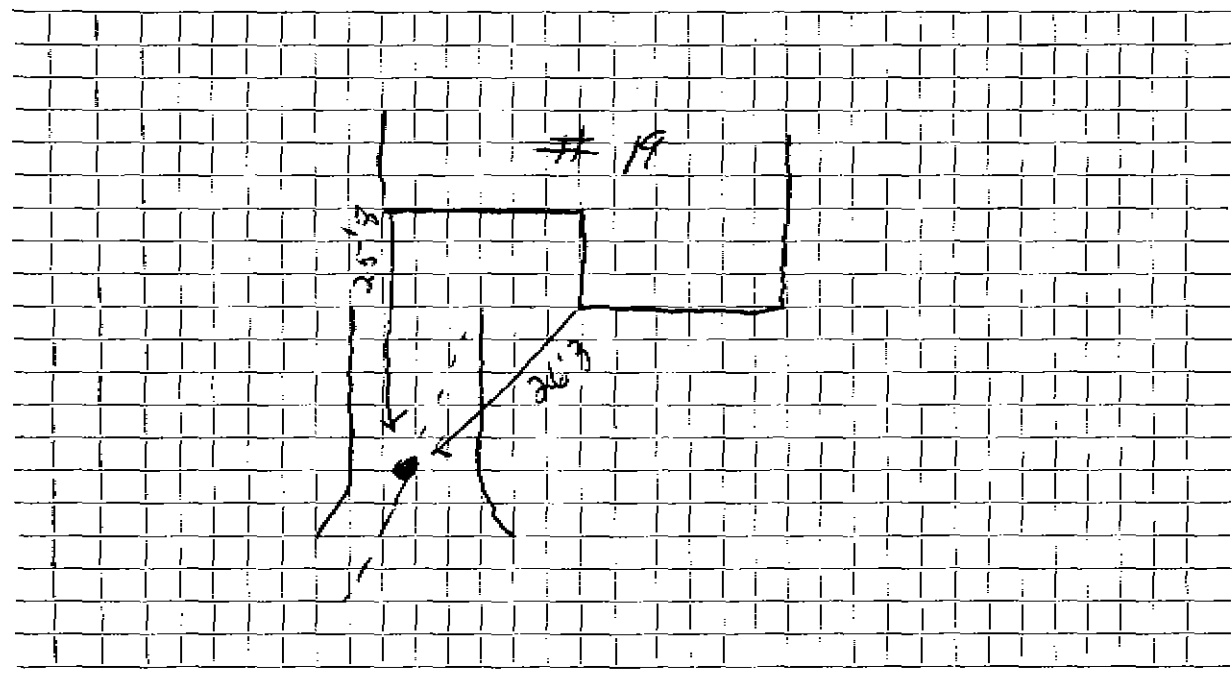

Connection made in Street. Work completed

Remarks:
.....
.....