

WATER SERVICE RECORD

Name NEW HYDRANT

Service No.

Address


Location EMERALD ST.

Repair—Renewal—New Service

DATE _____

TOWN OF LEXINGTON — BOARD OF PUBLIC WORKS
WATER DIVISION

Sketch of Service Here

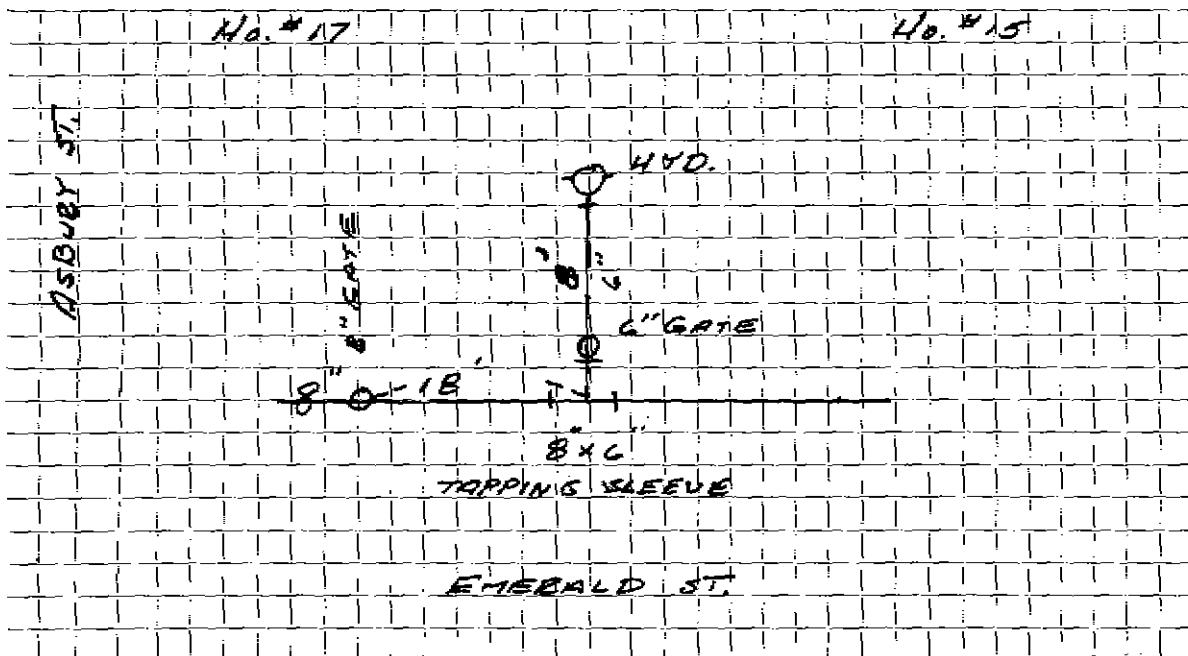

Connection made in EMERALD Street. Work completed

Remarks: