


DATE _____

TOWN OF LEXINGTON — BOARD OF PUBLIC WORKS

WATER DIVISION

Sketch of Service Here

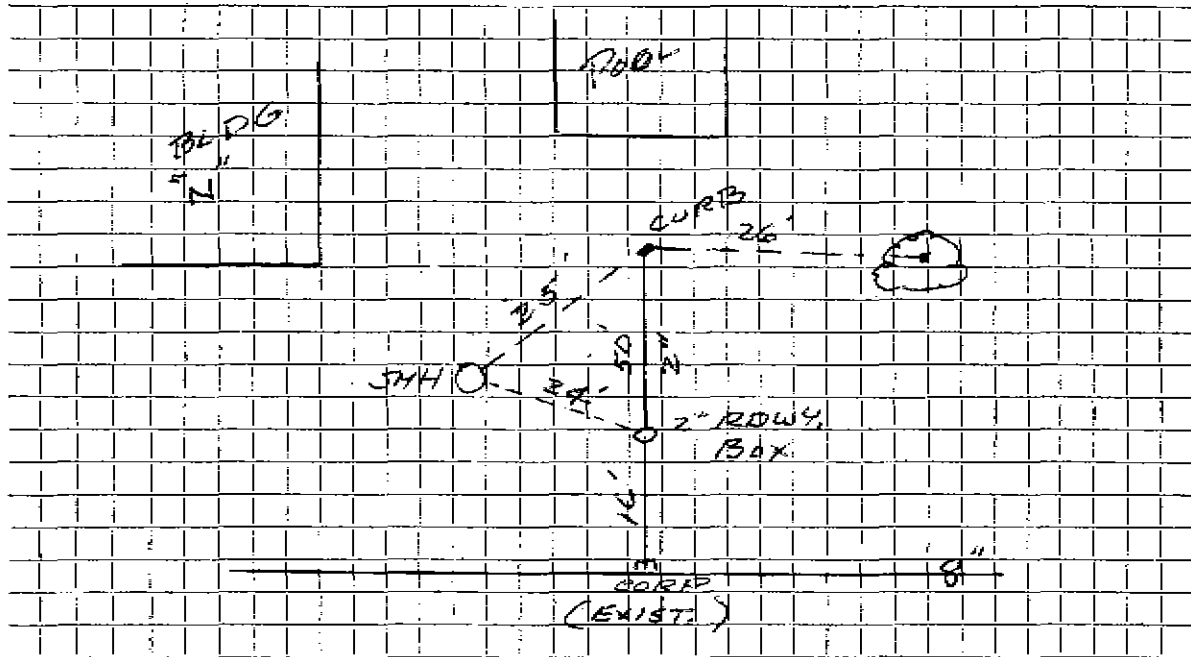

Connection made in EMERSON GARDEN RD. Street. Work completed

Remarks: NEW 2" SERU. @ EMERSON GARDEN COND'S