


DATE _____

TOWN OF LEXINGTON — BOARD OF PUBLIC WORKS
WATER DIVISION

Sketch of Service Here
EMERSON GARDEN

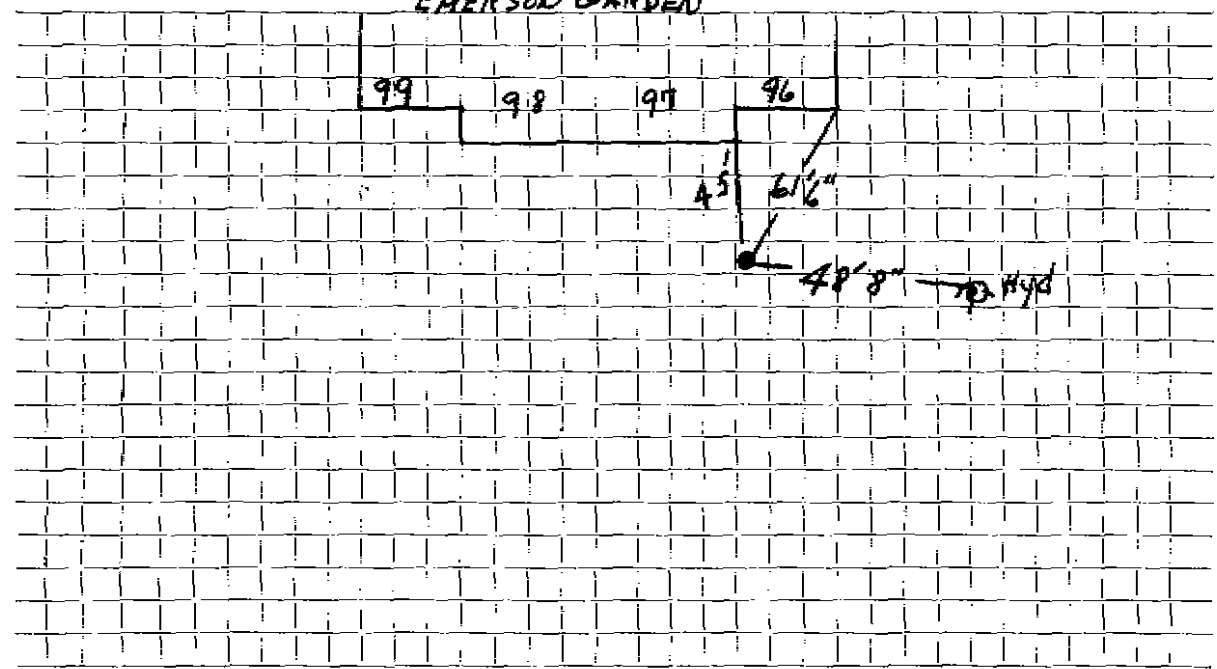

Connection made in Street. Work completed

Remarks:
.....
.....