


DATE 9 OCTOBER 1996

TOWN OF LEXINGTON — BOARD OF PUBLIC WORKS

WATER DIVISION

Sketch of Service Here

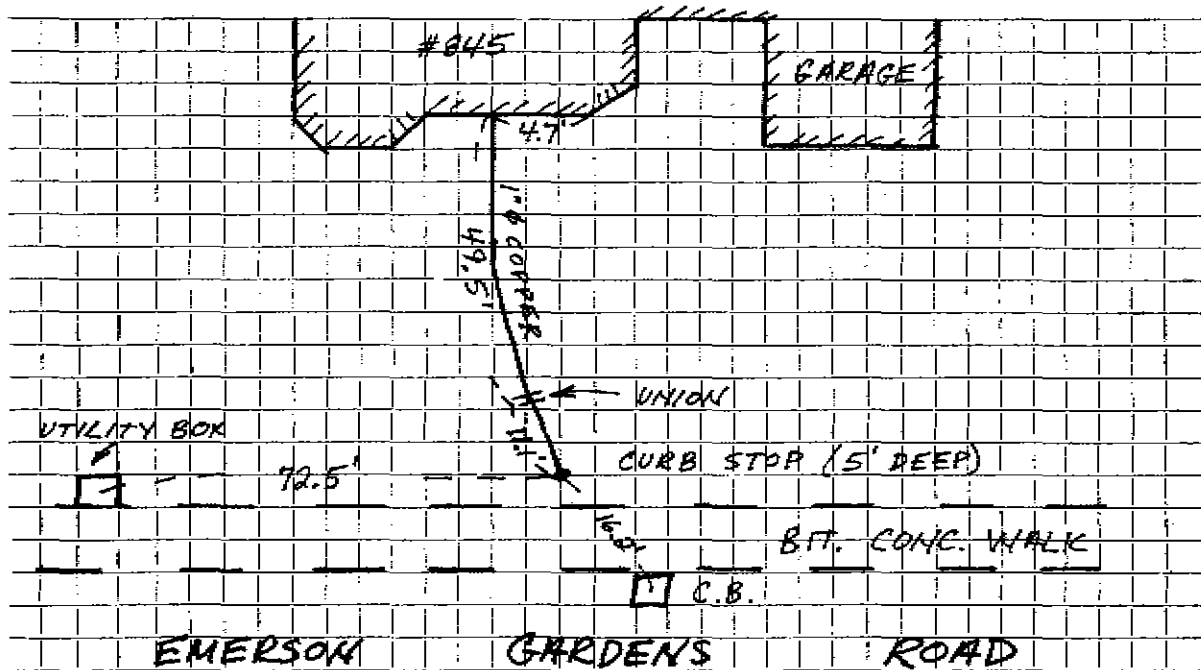

Connection made in EMERSON GARDENS ROAD Street.

Work completed J.M. MCLAUGHLIN

Remarks: