

WATER SERVICE RECORD

Name

Service No.

Address 851 EMERSON GARDEN RD

Location

PERMIT NO. 0977-SEAN TOCCI


Repair—Renewal—New Service - WAS INTO BACK OFF SIDEWALK (ARLEX OIL)

Date	Material MELANGLIN CONT	Amount	Total	Date	Amount
6/25/97	52' 1" C				1" COPP
	1" VALVE				1" COPPER
	1 1" UNION BEHIND Sidewalk			4/25/97	REPLACE
					1" CURB COMP
					1 1" UNION
					BUFF TO BOX

DATE JUNE 25, 1997

TOWN OF LEXINGTON — BOARD OF PUBLIC WORKS  
WATER DIVISION

Sketch of Service Here

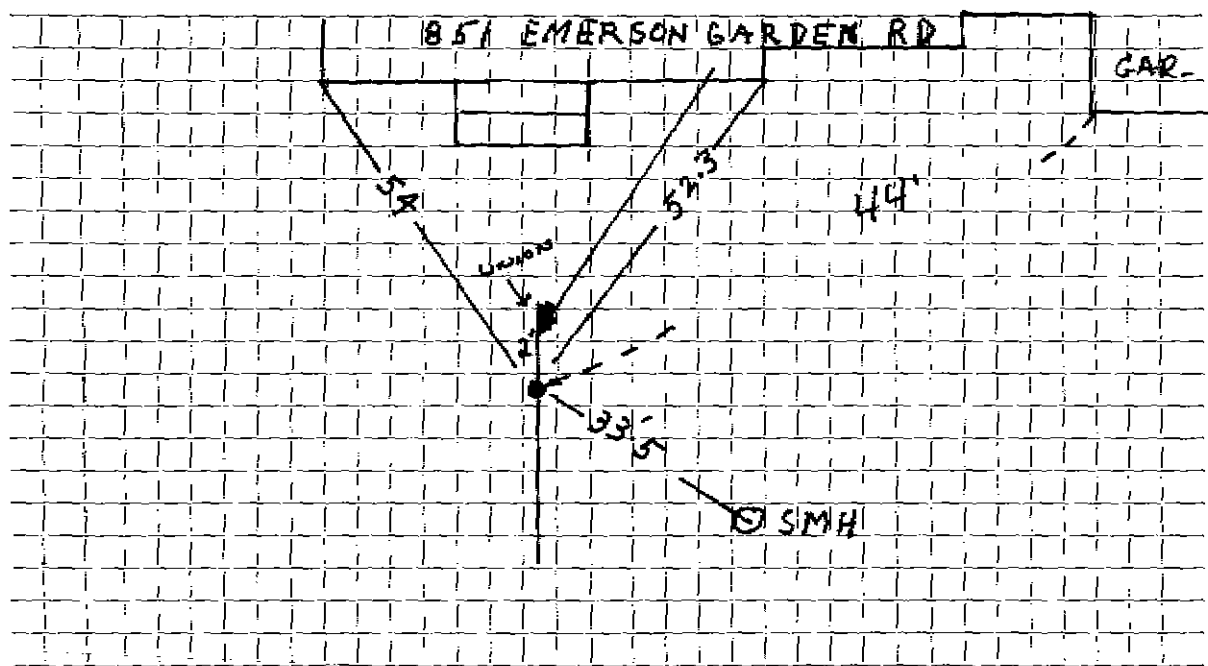

Connection made in ..... Street. Work completed .....

Remarks: 6/25/97 INST. NEW 1" Comp. Sock + UNION