WATER SERVICE RECORD


855 EMERSON GARDENS ROAD Name Service No. Address Location Repair-Renewal-New Service Material Total Date Date Amount Amount

_			_					
٦,	Α.	ΤĘ	Ξ	 ~	 	 	 	_

TOWN OF LEXINGTON - BOARD OF PUBLIC WORKS

WATER DIVISION

Sketch of Service Here

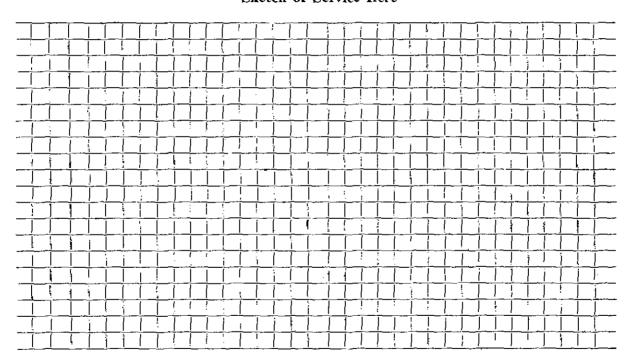

Connection made in St	treet. Wo	ork completed .	 	.,.,	
Remarks:		**********	 * * * * * * * * * * *		
,.,.,			 • • • • • • • • • •		