


DATE _____

TOWN OF LEXINGTON — BOARD OF PUBLIC WORKS

WATER DIVISION

Sketch of Service Here

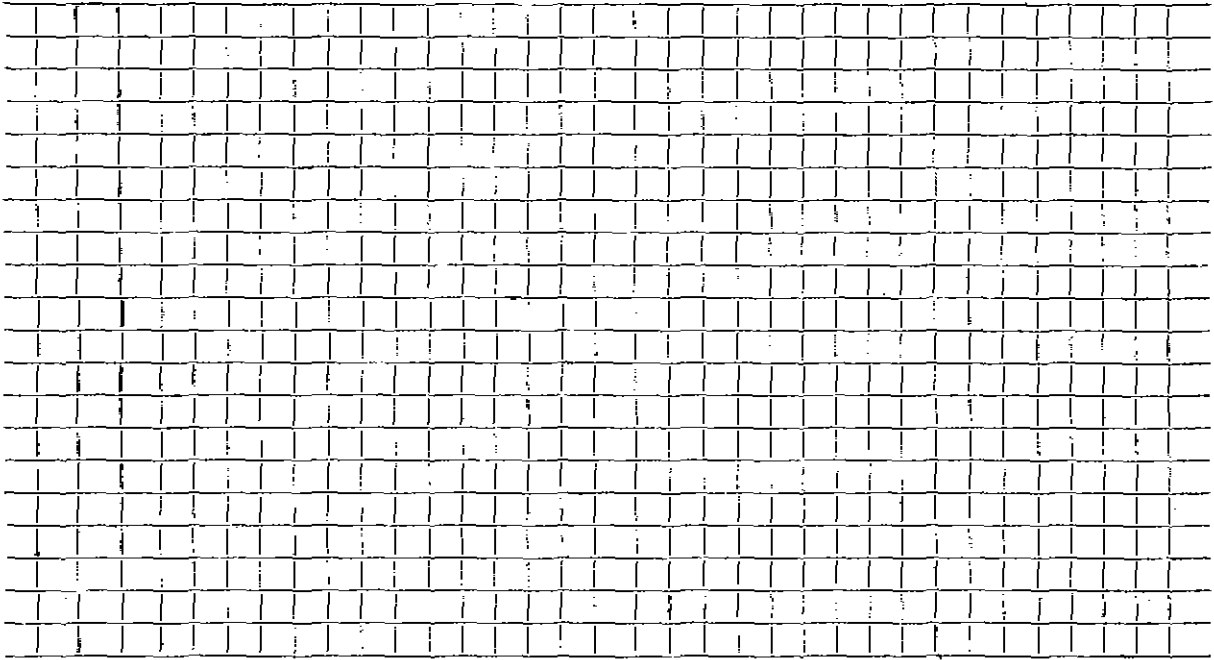


Connection made in Street. Work completed

Remarks:
.....
.....

9123

Bill
SOMER
APR 25 1995

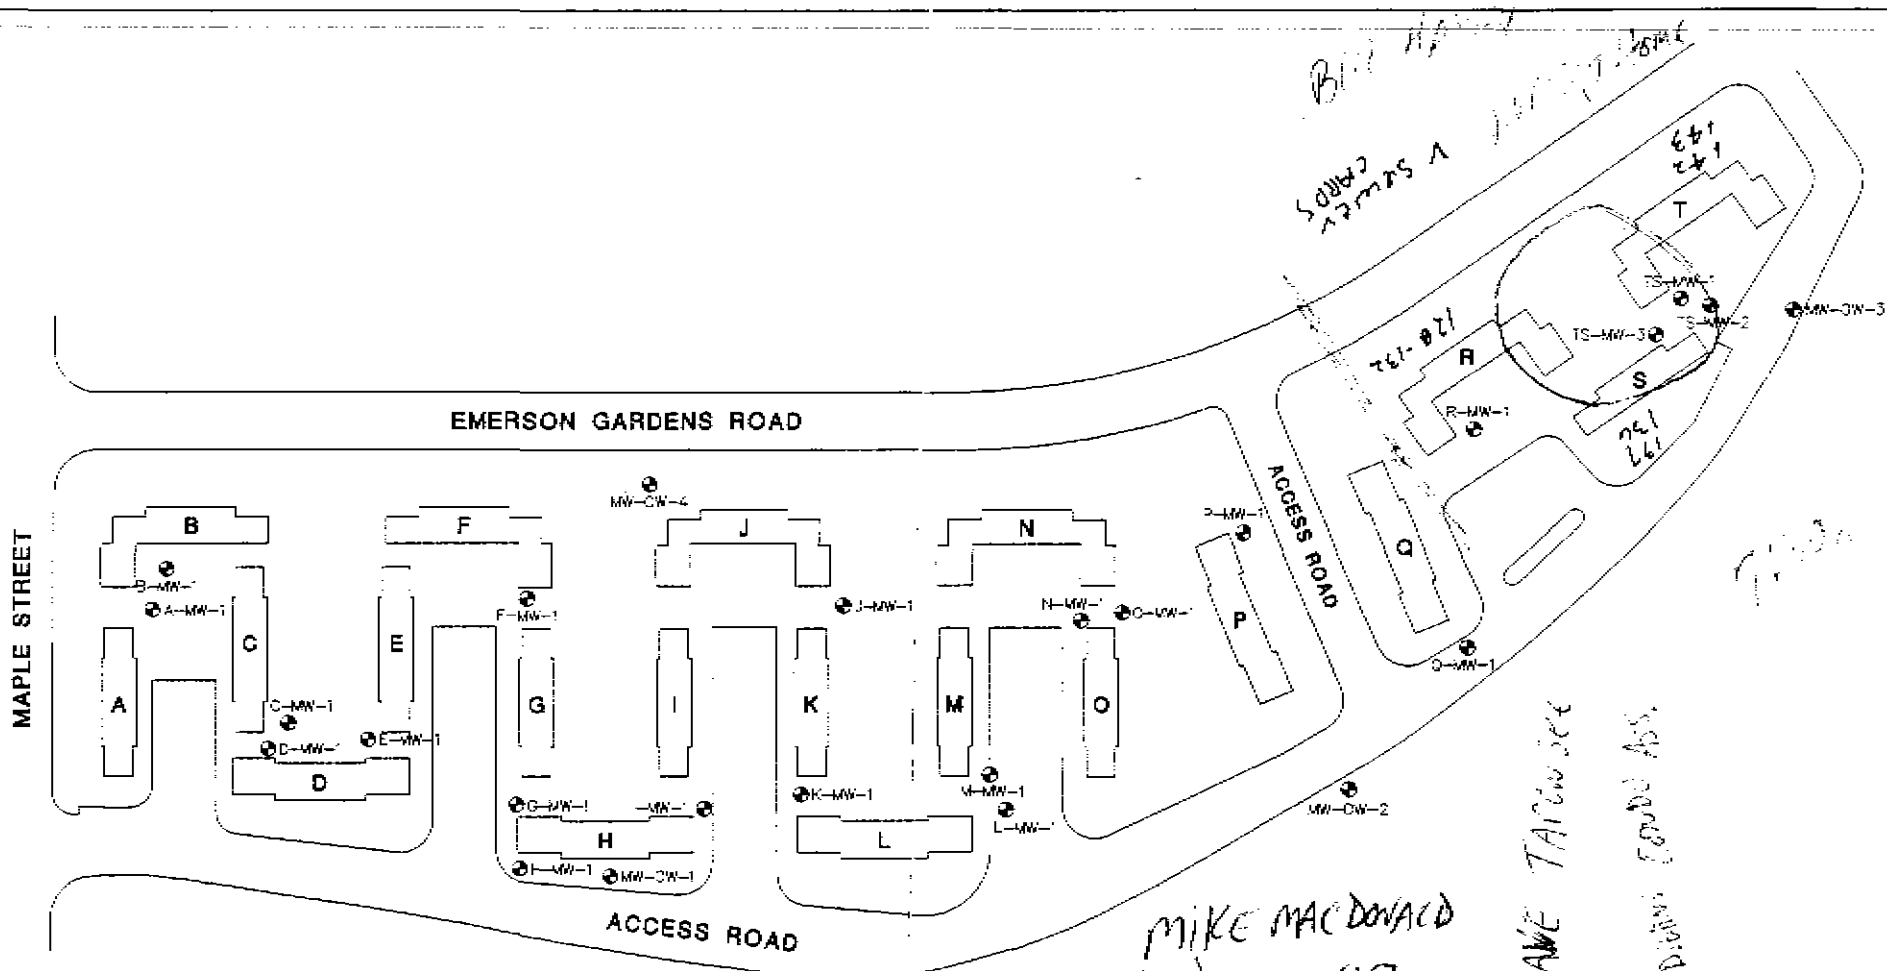

MAPLE STREET

EMERSON GARDENS ROAD


ACCESS ROAD

ACCESS ROAD

MIKE MACDONALD
(508) 250-1617

DAVE TAYLOR

DIVISION ENGINEER

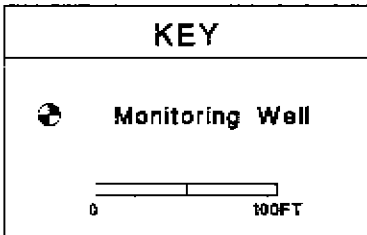

EMERSON GARDENS
TONY MARIANO

EMERSON GARDENS CONDOMINIUMS
EMERSON GARDENS ROAD LEXINGTON, MA

FIGURE 2 SITE PLAN

Produced By



Lexwood, Inc.
295 Littleton Road
Chelmsford, MA
01824

Date Drawn: 2/27/95	File Name: C:\MPN\EMERSON\SITEPLAN	Drawn By: MPN
------------------------	---------------------------------------	------------------