


DATE _____

TOWN OF LEXINGTON — BOARD OF PUBLIC WORKS
WATER DIVISION

Sketch of Service Here

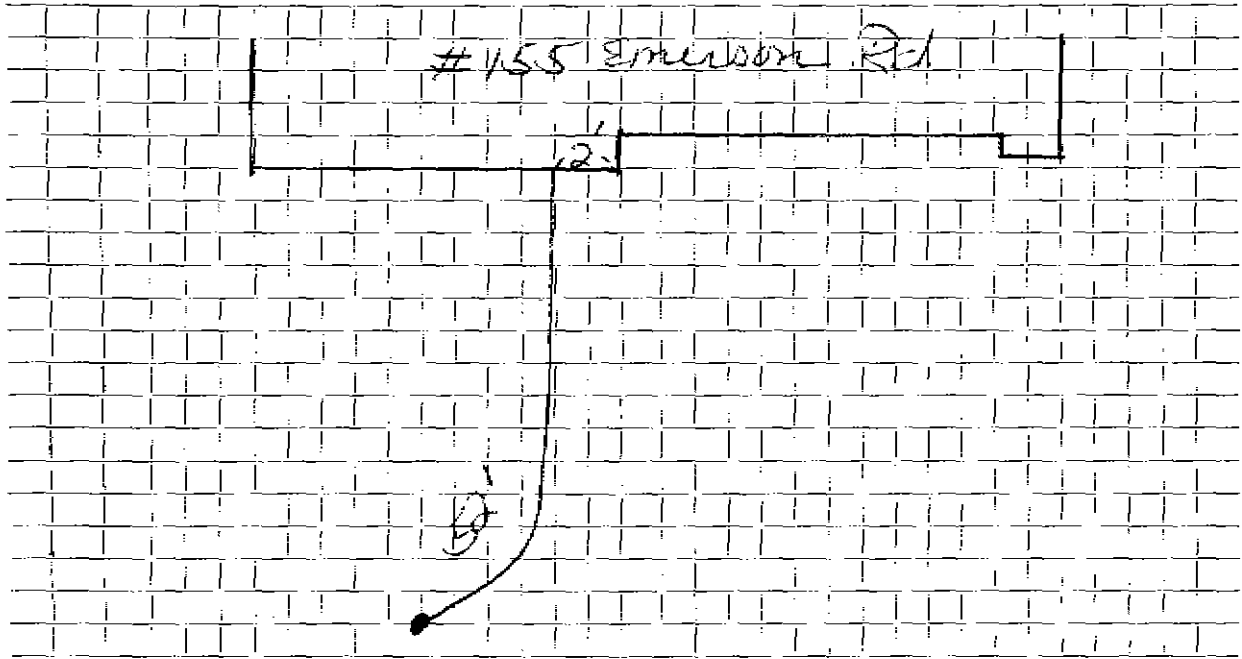

Connection made in EMERSON ROAD Street. Work completed 12-18-75

Remarks:

.....

.....