
		•	•	•		· ·		
H.	B.W.1501C		WATER	CEDVICE	BERMAN			
N	Name		WATER SERVICE REC		REGERO	Service No.		
A	ddress	157 Emerson Road		<del></del>	·			
	cation							
R	epair—R	enewal—New Service Da	ve Eagle #2265					
Da		Material	Amount	Total	Date		Amount	
5/7/73	521	1" Copper tubing				:		
					<del></del>			
		<u> </u>	ļ					
	! <del> -</del>	 <del>-</del>	'	<del>-</del>	· 		<u> </u>	
			 		<u> </u>	<u> </u>	<u> </u>	
		<u> </u>	ļ			<u> </u>	<u> </u>	
		: 	<del> </del>		   <del>-</del>	<u> </u>	<del></del>	
	! - <del></del>	<u> </u>	<u> </u>			<del> </del>	<del> </del>	
				<del> </del>		<u>'</u>	<del> </del>	
		<del> </del>	├ <del> </del>		<del></del>	l		
		<del> </del>		——————————————————————————————————————	- - -	<del>                                     </del>	<del> </del>	
	_ <u>!</u>	<u>'</u>	<del>'</del>	<del></del> -		<del> </del>	<del> </del>	
				<u> </u>	<u> </u>	- <del></del>	<del> </del>	
		<del> </del>	<del> </del>	+	<del></del>	<del>!</del>	<del> </del>	
		- <del></del> - <del></del> - <del></del> -	<del>                                </del>	<del>-</del>	<del></del>	ļ	<del> </del>	
<del>_</del>			<del></del>	   	_ <del></del>	† <del></del>	<u> </u>	
_ <del></del>	<del></del>			+ <del></del>	<del></del>		<del> -</del> <del></del>   <del></del>	

D	Δ	т	F	

## TOWN OF LEXINGTON - BOARD OF PUBLIC WORKS

## WATER DIVISION

## Sketch of Service Here

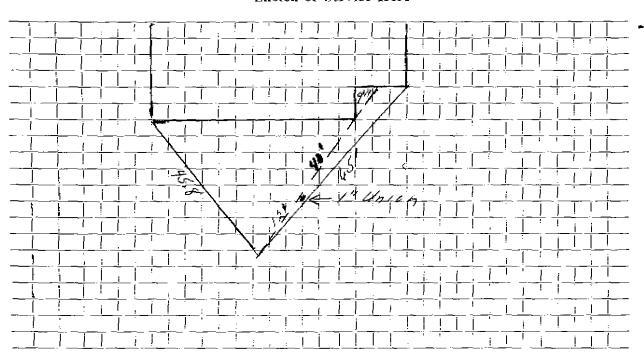

Connection made in	Street.	Work completed
Remarks:	,	