




DATE \_\_\_\_\_

TOWN OF LEXINGTON — BOARD OF PUBLIC WORKS

WATER DIVISION

Sketch of Service Here

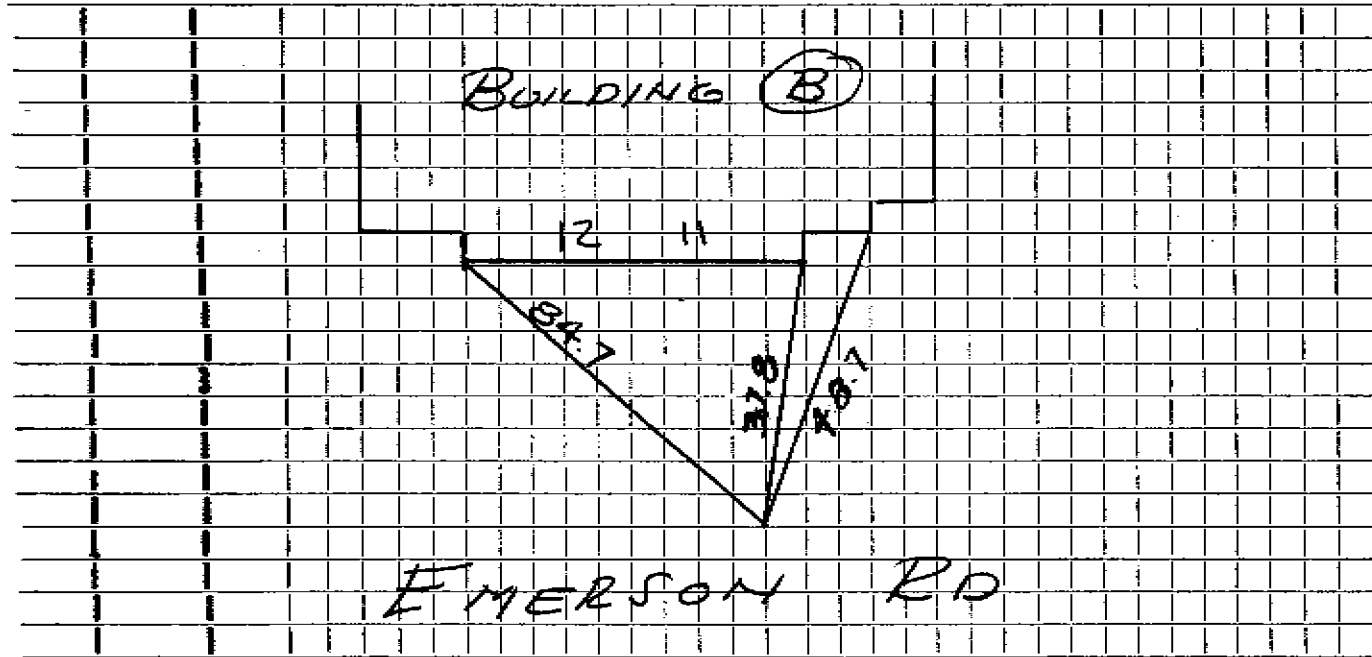

Connection made in \_\_\_\_\_ Street. Work completed \_\_\_\_\_


Remarks: ..... SERVICE FOR BUILDING B .....



WATER DIVISION

DATE

Sketch of Service Here

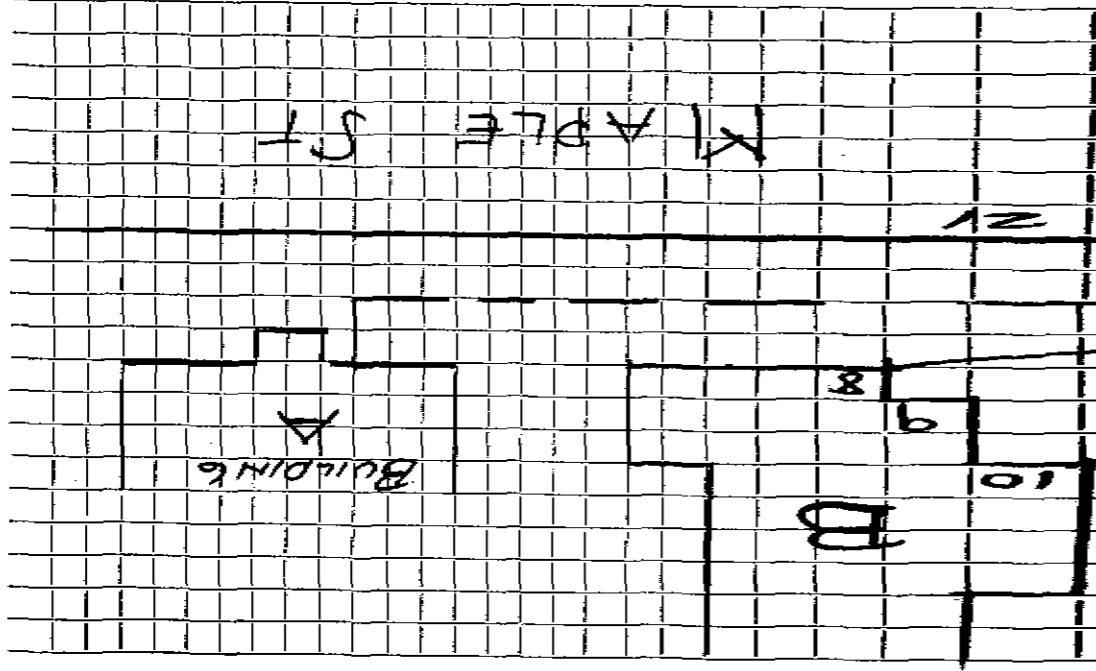

Street.

Work completed


FOR BUILDING





WATER DIVISION

Sketch of Service Here

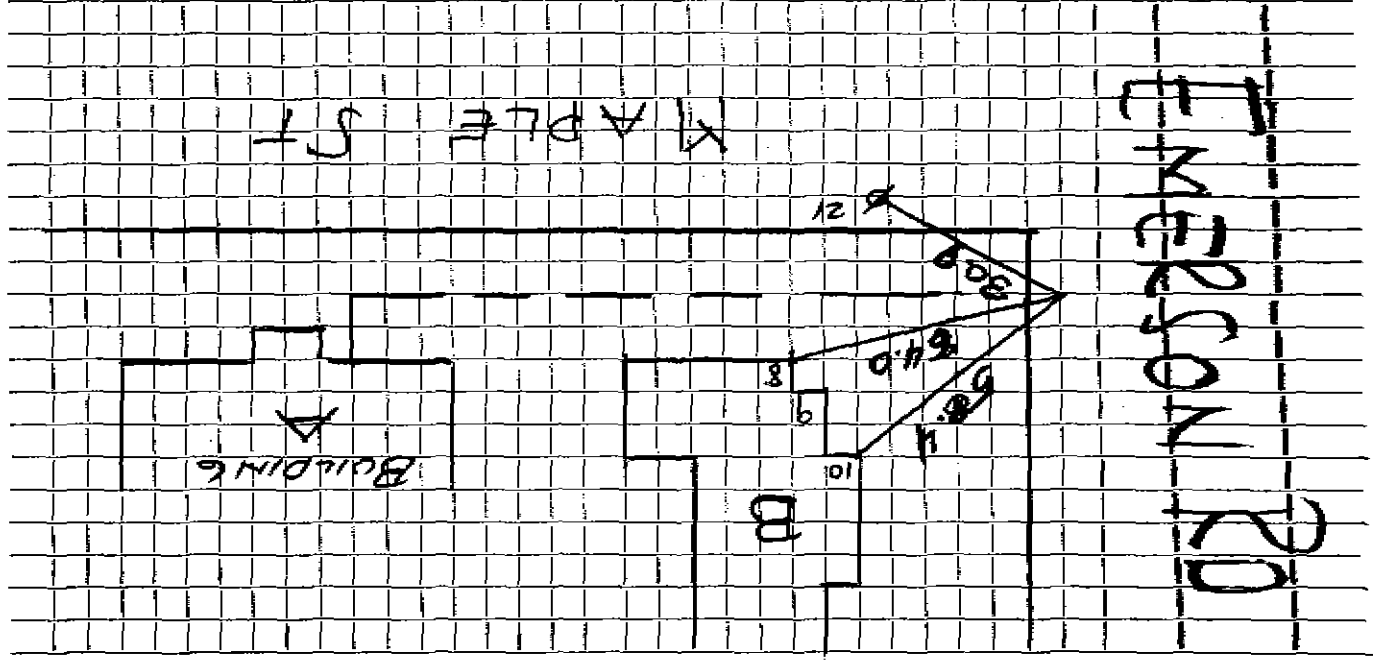

Work completed

Street

EMERSON RD FOR BUILDING

Connection made in

Remarks: