


DATE _____

TOWN OF LEXINGTON — BOARD OF PUBLIC WORKS
WATER DIVISION

Sketch of Service Here
273 EMERSON RD

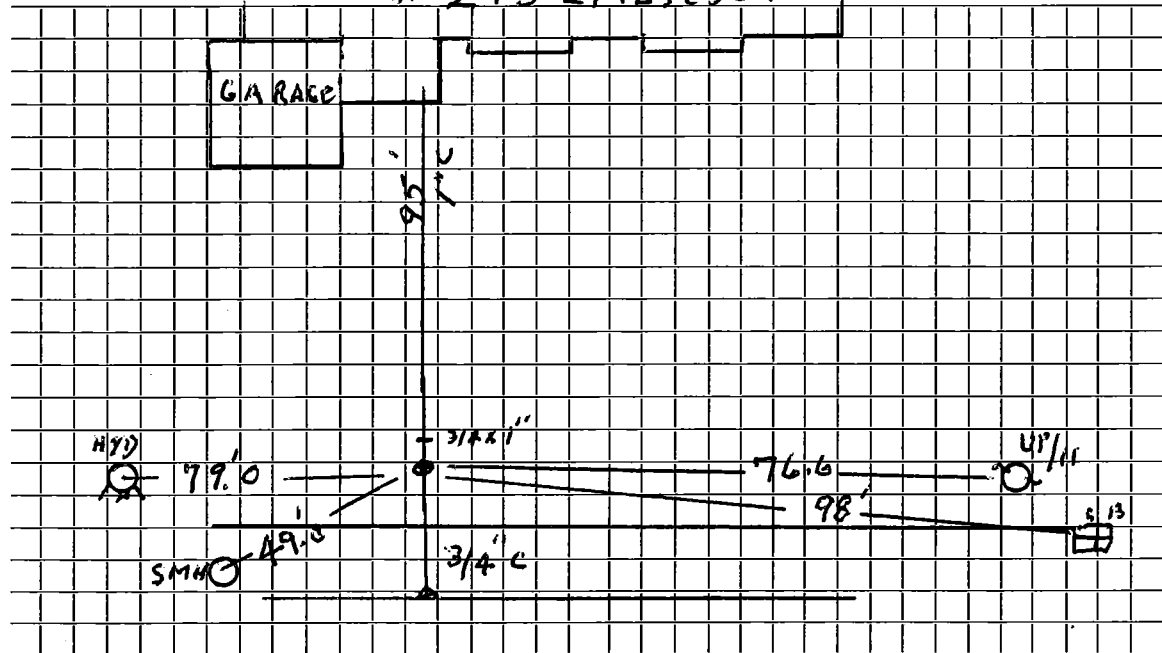

Connection made in Street. Work completed 10/10/09 J. Mel.

Remarks:
.....
.....