

WATER SERVICE RECORD

4215

Name John E. Gallagher

Service No. 99

Address 219 111 Emerson Road (279 Emerson Road) changed from # 10 to # 279

Location Lot #19

~~Repair~~ ~~Renewal~~ ~~New Service~~

Comm 7-6-59


Date	Material	Amount	Total	Date	Material	Amount
5-23-59	Labor	3 54		5-21-59	Deposit	100 00
	10% O. H.	35	3 89	7-6-59	Refund	56 75
83	3/4" Copper Tubing @.3666	30	43			45 25
1	3/4" C x 1/2 TWH Stop & Waste	5	88		NON CHARGE	
1	3/4" C 3 part Union	2	30	10-18-58	Labor	5.10
1	Hr. Trucking		75	18	3/4" Copper tubing@.37	6.66
			43 25	1	3/4" C Corp Cock	4.64
				1	3/4" C Curb Cock	6.03
				1	Box & Rod	5.00
						27.43
				5-23-59	1 1/2 Straight Tailpiece	50
					1 1/2 Offset Tailpiece	50
						28 43

DATE 3/8/69

TOWN OF LEXINGTON — BOARD OF PUBLIC WORKS

WATER DIVISION

Sketch of Service Here

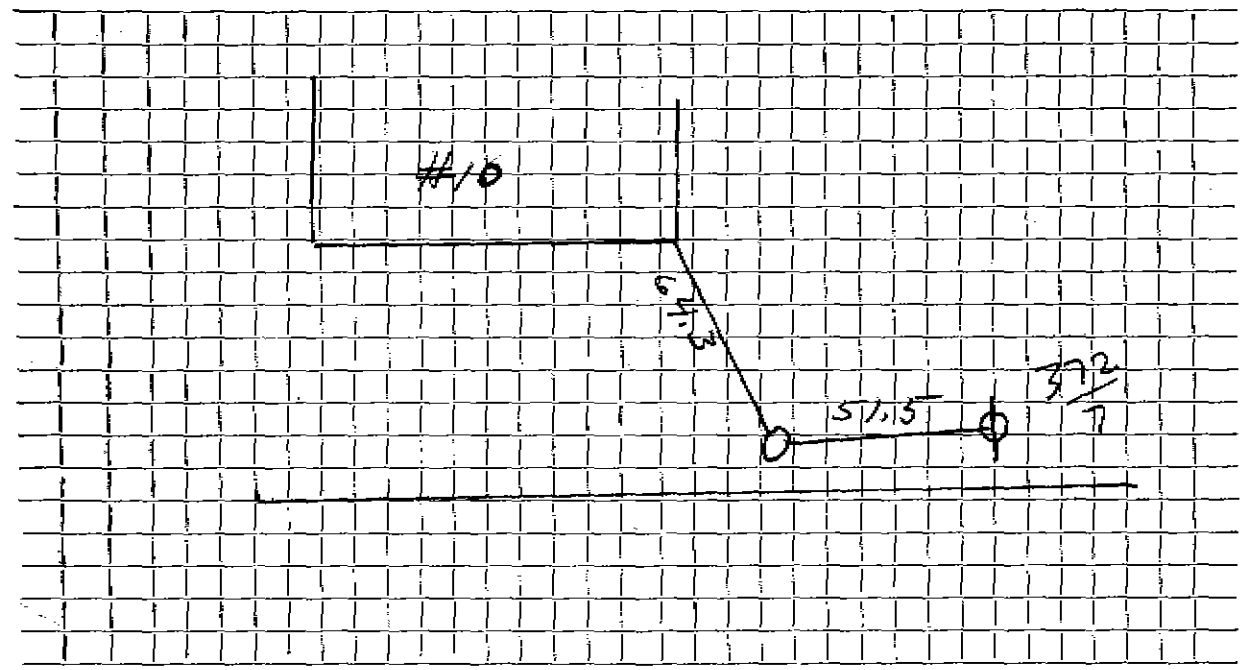

Connection made in EMERSON RD. Street. Work completed

Remarks: