

## WATER SERVICE RECORD

2200

Name Moore Realty TrustService No. 49Address <sup>205</sup> B Emerson Road (# 285 Emerson Road) (changed from # 8 to # 285)

Location


~~Repair~~ ~~Renewal~~ ~~Service~~ New ServiceComm 8-4-58

Date	Material	Amount	Total	Date		Amount
4-24-58	Labor	2.14		4-21-58	Deposit	50.00
	10% overhead	.21	2.35	8-4-58	Refund	9.19
80'	3/4" Copper tubing @.37		29.60			40.81
1	3/4" C x 1/2" I.W.H. Stop & Waste		5.84		NON CHARGE	
1	3/4" C 3 part union		2.27	1	1/2 Offset tail piece	.50
1	hr. Trucking @.75		.75	1	1/2 Straight tail piece	.50
			40.81			1.00
				10-23-57	Labor	1.76
				12'	3/4" Copper tubing	4.50
				1	3/4" C Corp Cock	4.64
				1	3/4" C Curb Cock	5.94
				1	Box & Rod	4.62
				1	hr. Trucking @.75	.75
						23.21

TOWN OF LEXINGTON — BOARD OF PUBLIC WORKS

WATER DIVISION

Sketch of Service Here

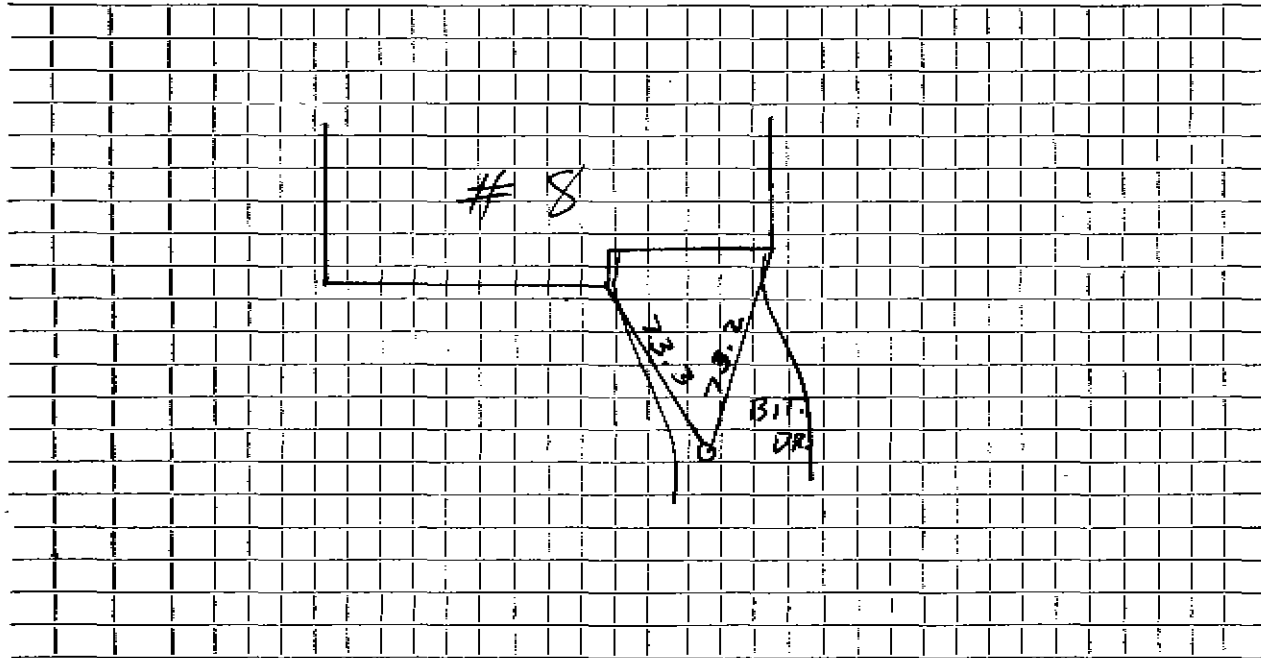

Connection made in E. MEIGSON RD. Street. Work completed .....

Remarks: .....  
.....  
.....