

WATER SERVICE RECORD

#4313

Name Moore Realty Trust

Service No. 265

Address 286 Emerson Road (286 Emerson Road) Changed from # 7 to #286

Location

Registration Renewal - New Service

Comm 3-16-59

Date	Material	Amount	Total	Date	Amount	
11/25/58	Labor	5 80		11-24-59	Deposit	30 00
	10% overhead	58	6 38	3-24-59	Paid	16 69
	85' - 3/4" Copper tubing @ .37		31 45		NON CHARGE	46 69
	1 - 3/4" Cx 1/2 I.W.H. Stop & Waste		5 84	10/23/59	Labor	1 76
	1 - 3/4" C. Union (3 part)		2 27	24" - 3/4"	Copper tubing	9 00
	1 hr. Trucking		75	1 3/4"	C Corp Cock	4 64
			46 69	1 3/4"	C Curb Cock	5 94
				1	Box & Rod	4 62
				1 Hr.	Trucking @ .75	75
						26 71
				1 - 1/2"	Straight tailpiece	50
				1 - 1/2"	Offset tailpiece	50
						27 71

Bill sent 3-16-59


16 69

DATE _____

TOWN OF LEXINGTON — BOARD OF PUBLIC WORKS

WATER DIVISION

Sketch of Service Here

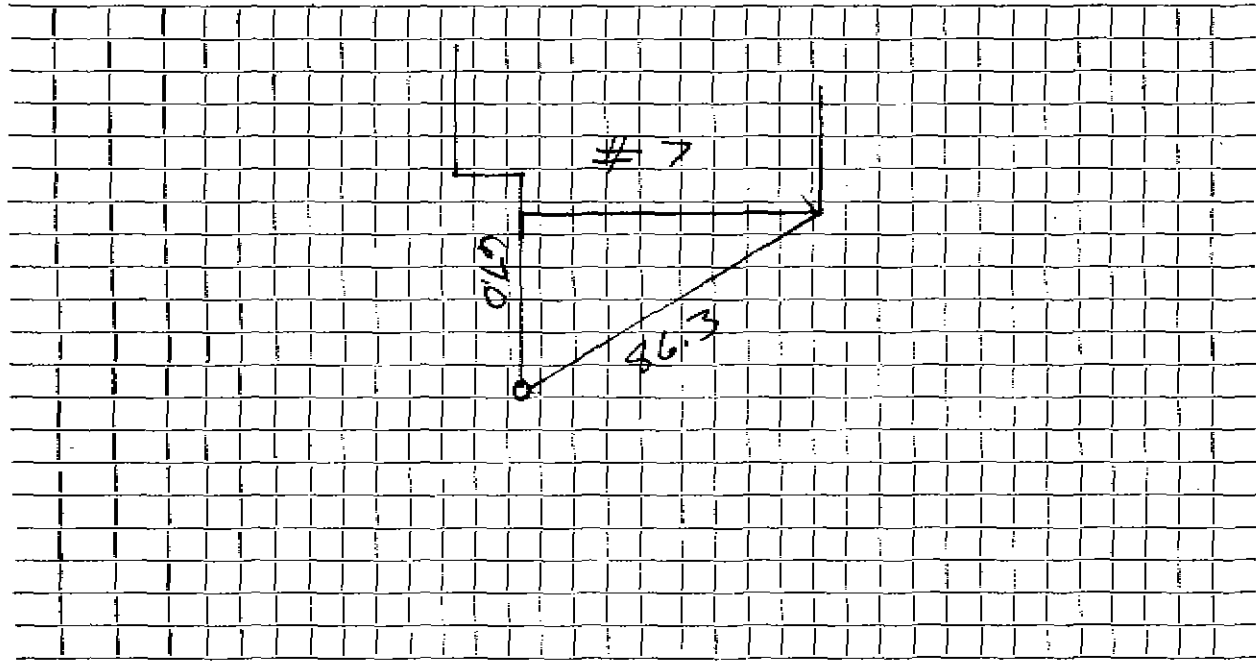

Connection made in Street. Work completed

Remarks:
.....
.....