

## WATER SERVICE RECORD

#6026

Name Moore Realty Trust

Service No. 51

Address 287 ~~★~~ Emerson Road (287 Emerson Road) Changed from #6 to #287

Location

~~Repair - Renewal - New Service~~

Comm 8-4-58

Date	Material	Amount	Total	Date	Material	Amount
4-29-58	Labor	2.14		4-23-58	Deposit	50.00
	10% overhead	.21	2.35	8-4-58	Refund	<del>5.49</del>
	90' 3/4" Copper tubing @ .37		33.30			44.51
	1 3/4" C x 1/2" I.W.H. Stop & Waste		5.84		NON CHARGE	
	1 3/4" C 3 part Union		2.27		1 1/2" Straight tail piece	.50
	1 hr. Trucking @ .75		.75		1 1/2" Offset tail piece	.50
			44.51			1.00
11/14/53	160' 1" copper			10-23-57	Labor	1.76
	1 3/4 x 1 union				9' 3/4" Copper tubing	3.38
	1 buff box				1 3/4" C Corp Cock	4.64
					1 3/4" C Curb Cock	5.94
					1 Box & Rod	4.62
					1 hr. Trucking @ .75	.75
						22.99

DATE \_\_\_\_\_

TOWN OF LEXINGTON — BOARD OF PUBLIC WORKS

WATER DIVISION


*new base*

Point of Service Here

*11/14/03*

Gage

Gage

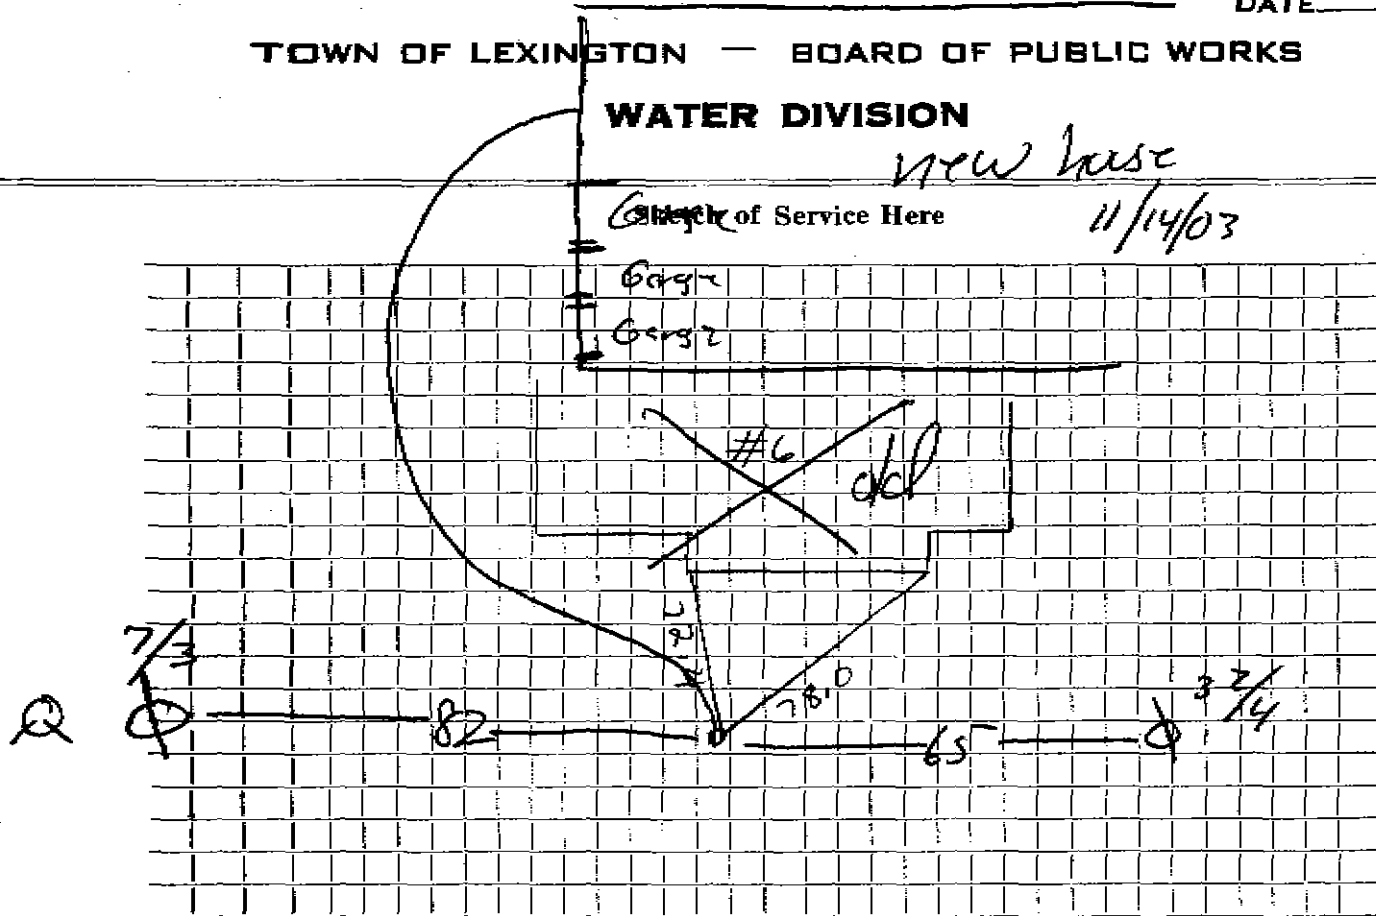

Connection made in *EMERSON RD.* Street. Work completed .....

Remarks: *6" pipe to 3/4 x 1 union tape in trench over water line* .....