




DATE 9/10/19

TOWN OF LEXINGTON — BOARD OF PUBLIC WORKS

WATER DIVISION

Sketch of Service Here

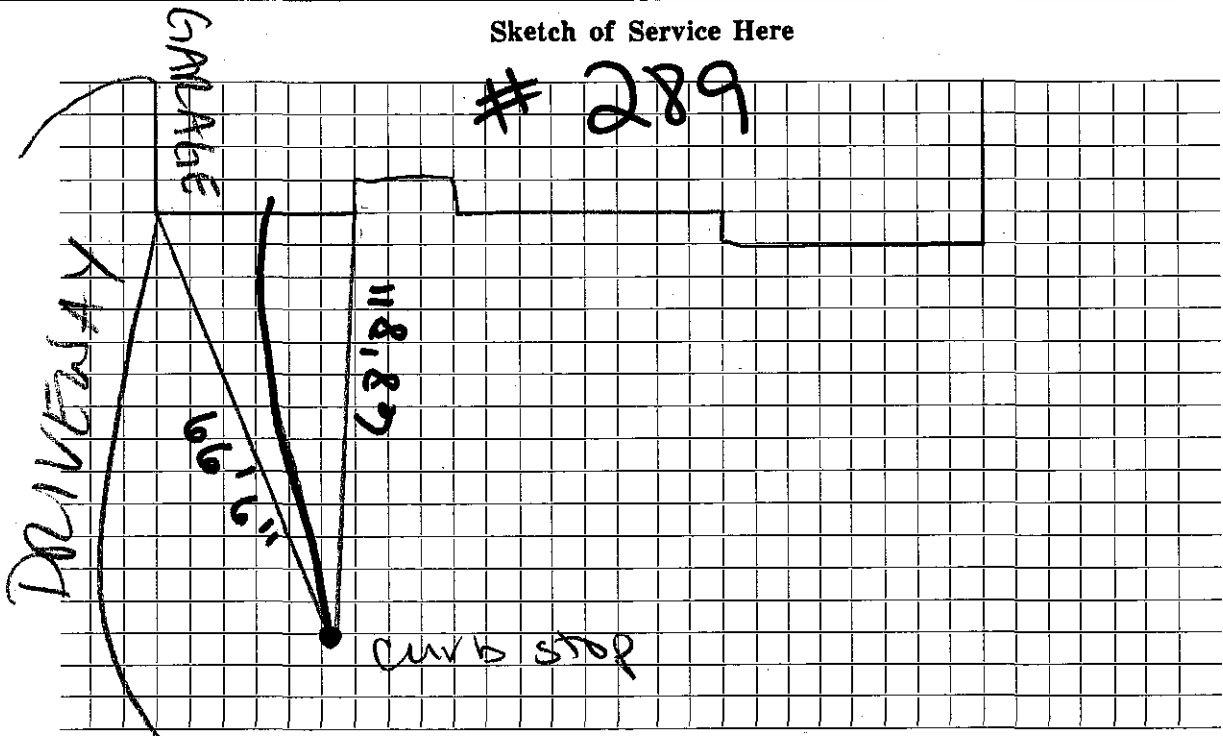

Connection made in ... Emerson Rd ... Street. Work completed .....

Remarks: .....  
.....  
.....