

WATER SERVICE RECORD

Name Mark Moore, Jr.

Service No. 100

Address 10 Essex Street

Location

~~Repair - Renewal~~ - New Service


Service in to curb

Date	Material	Amount	Total	Date	Amount	
5/16/56	Labor	1 95		5-14-56	Deposit	35 00
	10% overhead	20	2 15	8-6-56	Balance	11 14
	33' - 3/4" Copper tubing @ .4850	16 00			NON CHARGE	23 86
	1 - 3/4Cx $\frac{1}{2}$ I.W.H. Stop & Waste		4 96	5/16/56		
	1 hr. trucking		75	1 - $\frac{1}{2}$ " Straight tailpiece		50
			23.86	1 - $\frac{1}{2}$ " Offset tailpiece		50
						1 00
				9/8/55		
				15' - 3/4" Copper tubing		
				1 - 3/4" C Corp Cock		
				1 - 3/4" C Curb Cock		
				1 - Box and Rod		

TOWN OF LEXINGTON — BOARD OF PUBLIC WORKS

WATER DIVISION

Sketch of Service Here

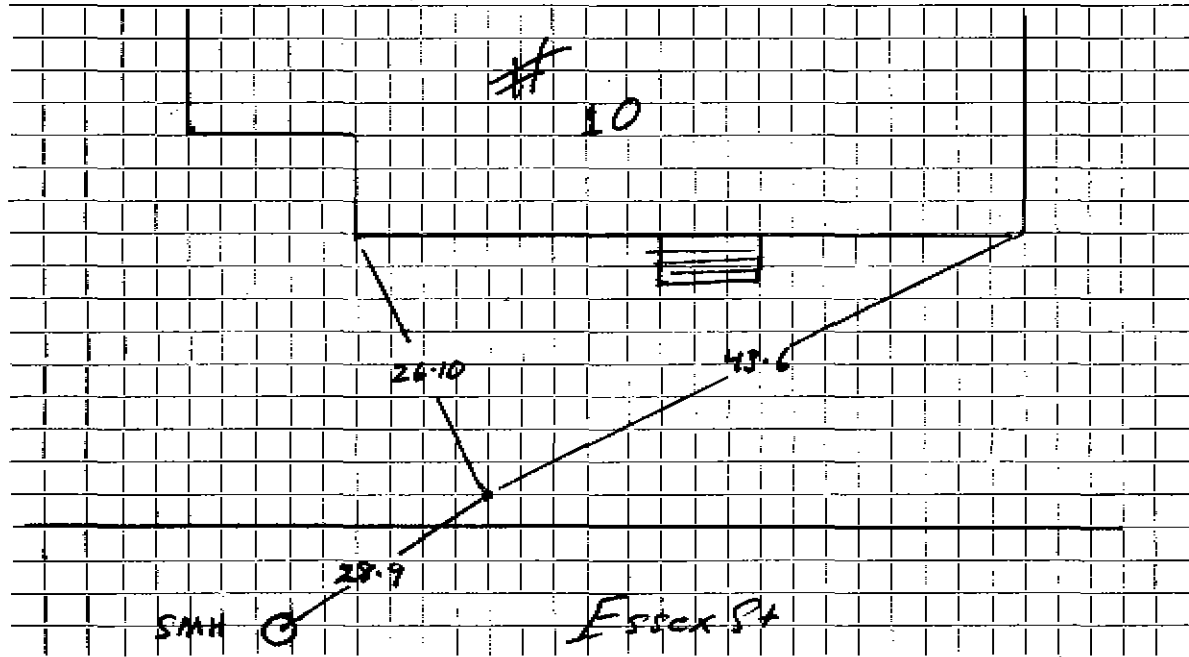

Connection made in Street. Work completed

Remarks:

.....

.....