

DATE _____


TOWN OF LEXINGTON — BOARD OF PUBLIC WORKS

10

WATER DIVISION

12

12 ESSEX ST. WATER
Sketch of Service Here

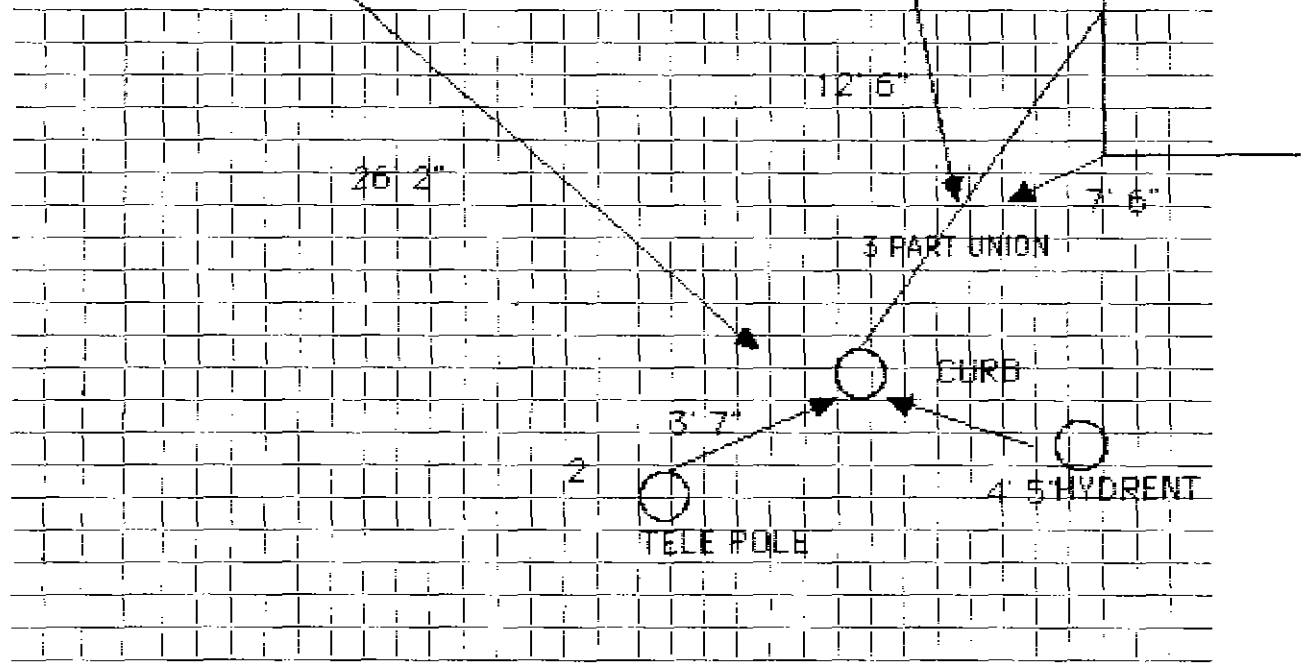

Connection made in Street. Work completed

Remarks:
.....
.....