

WATER SERVICE RECORD

Name _____

Service No.

Address

Page 5 of 5

Location

X Repairs Book—New Service


Curb only

Date	Material	Amount	Total	Date	Amount
12-17-55					
	30' 3/4" Copper				
	1 3/4" C. X 1/2 I.W.H. Stop + Waste				
				Non Charge	
				8/8/55 Labor	1 86
				10'-3 1/4" Copper tubing @ .384	3 64
				1-3/4" C. Curb Cock	4 67
				1-3/4" C. Corp Cock	4 33
				Box & Rod	3 90
				1 hr. trucking @ .75	.75
					19 34

DATE _____

TOWN OF LEXINGTON — BOARD OF PUBLIC WORKS
WATER DIVISION

Sketch of Service Here

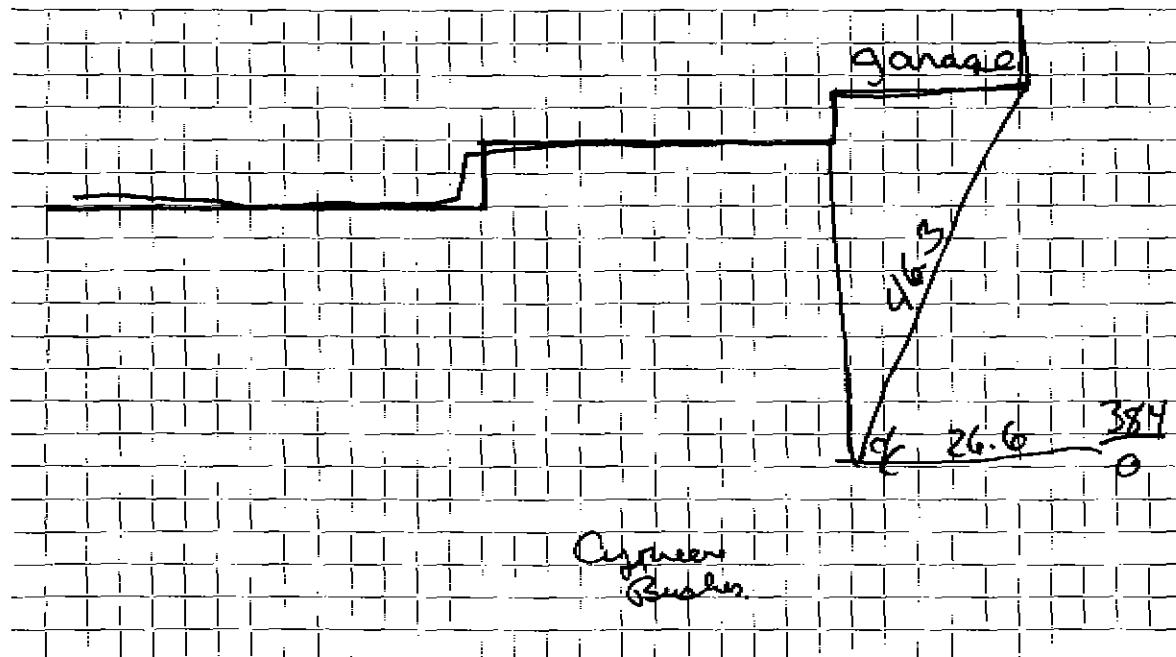

Connection made in Street. Work completed

Remarks:

.....

.....