

WATER SERVICE RECORD

#1569

Name Mark Moore Jr.

Service No. 241

Address 3 Essex Street, Lexington, Mass.

Location

~~Repair~~ ~~Renewal~~ New Service

Com. 11-21-55


Date	Material	Amount	Total	Date	Amount
7/26/55	Labor	3 56		7-25-55 Deposited	35 10
	10% Overhead	36	3 92	11-21-55 Refunded	(10 97)
	40'-3/4" Copper tubing@.384		15 36	Non Charge	24 03
	1-3/4" Cx 1/2" I.W.H. stop & waste		4 00	7/26/55 Labor	3 56
	1 hr. trucking@.75		75	20'-3/4" Copper tubing@.384	7 68
			24 03	1-3/4" C. Corp. Sock	4 33
				1-3/4" Cx 3/4" C. Gurb Sock	4 67
				1 Box & Rod	3 90
				1-3/8" offset tail piece	50
				1-3/8" straight tail piece	50
				1 hr. trucking	75
					25 89

DATE _____

TOWN OF LEXINGTON — BOARD OF PUBLIC WORKS

WATER DIVISION

Sketch of Service Here

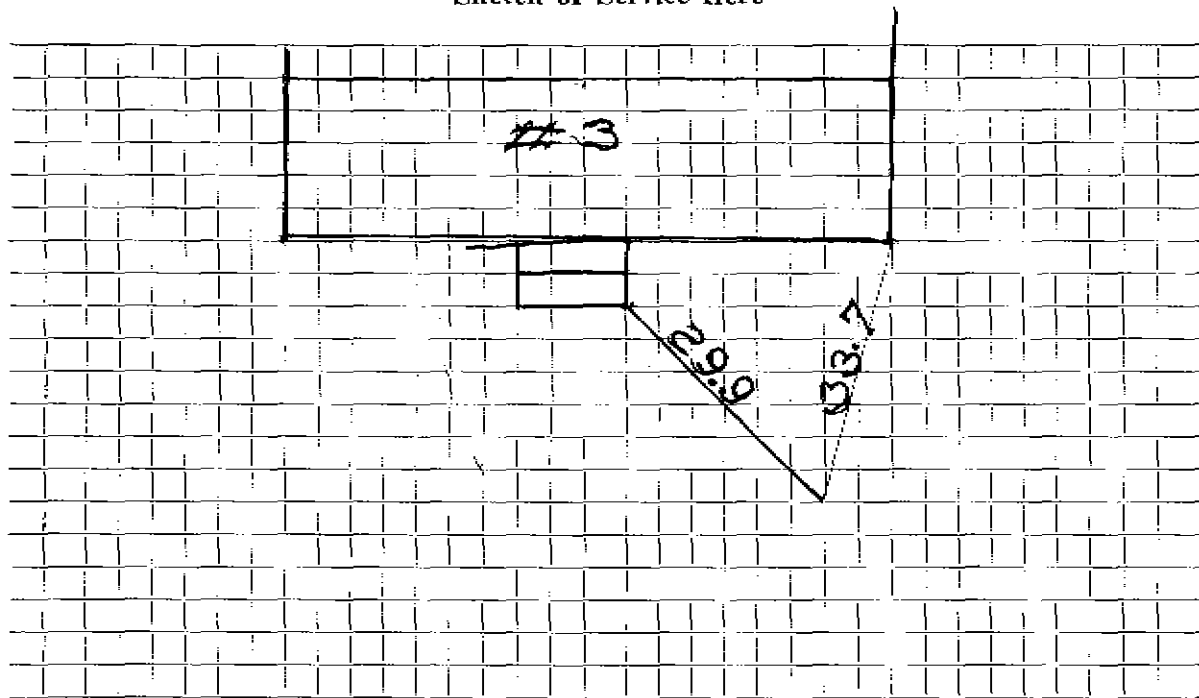

Connection made in Street. Work completed

Remarks:
.....
.....