

WATER SERVICE RECORD

5438

Name Mark Moore, Jr.

Service No. 397

Address 1 Essex Street

Location

Repair—Renewal—New Service

Com. 12-31-55


Date	Material	Amount	Total	Date	Amount
12/17/55	Labor	1 85		12-9-55 Deposited	\$ 35 00
	10% overhead	19	2 04	12-31-55 Refunded	(13 69
	30' 3/4" copper tubing @ .56	16 80		NON CHARGE	21 31
	1 Union (3 parts)		1 72	1 - 3" straight tail piece	50
	1 hr. trucking		75	1 - 1" offset tail piece	50
			21 31		1 00
				Water Off - no meter	
				Service was in to curb	
				NON CHARGE	
				9/8/55 10' 3/4" Copper Tubing	
				1 3/4" C Corp Cock	
				1 3/4" C Curb Cock	
				1 Box & Rod	

DATE _____

TOWN OF LEXINGTON — BOARD OF PUBLIC WORKS

WATER DIVISION

Sketch of Service Here

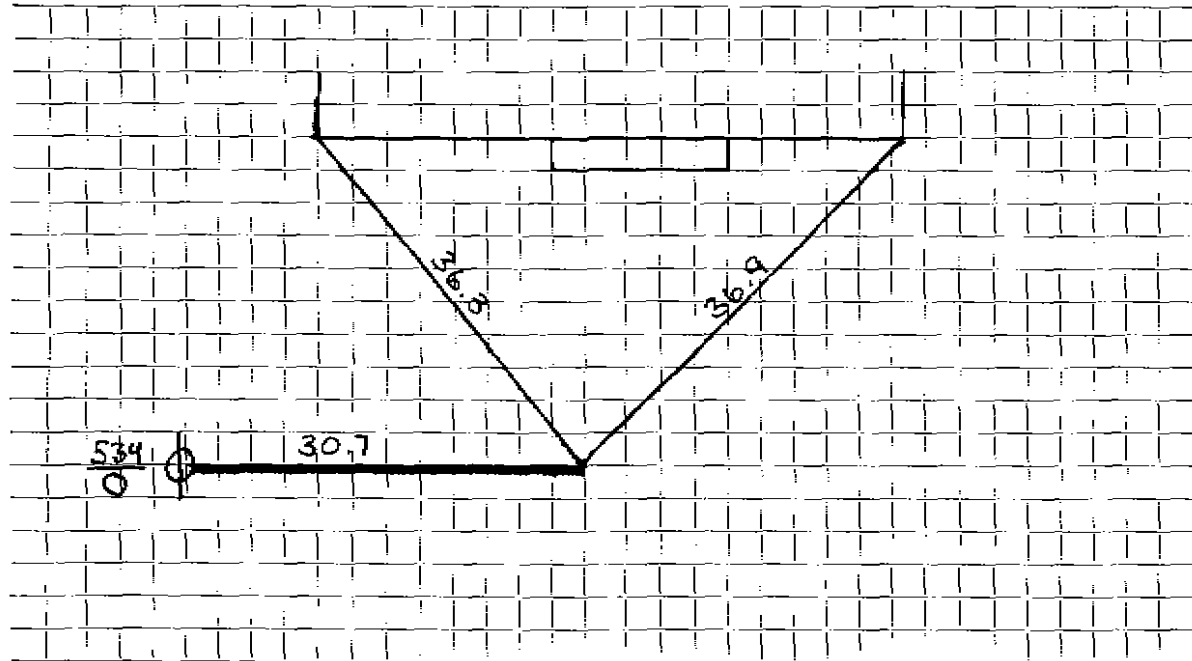

Connection made in Street. Work completed

Remarks:

.....

.....