

WATER SERVICE RECORD

4542

Name Mark Moore, Jr.

Service No. 299

Address 5 Essex St., Lexington

Location Ma 1:3 Diehl Rd., Lexington

~~Repair~~ ~~Renewal~~ New Service

Com. 11-21-55


Date	Material	Amount	Total	Date	Amount
9/14/55	Labor	3 70		8-29-55 Deposited	35 00
	10% Overhead	37	4 07	11-21-55 Refunded	(13 89)
	32' -3/4" Copper tubing@.384		12 29	Non Charge	21 11
	1-3/4" Cx 1/2 I.W.H. stopwaste		4 00	9/14/55 Labor	3 70
	1 hr. trucking@.75		75	24' -3/4" Copper tubing@.384	9 22
			21 11	1-3/4" C. corp cock	4 33
				1-3/4" C. curb cock	4 67
				1 Box & Rod	3 90
				1-1/2" straight tail piece	50
				1-1/2" offset tailpiece	50
				1 hr. trucking @.75	75
					27 57

DATE _____

TOWN OF LEXINGTON — BOARD OF PUBLIC WORKS

WATER DIVISION

Sketch of Service Here

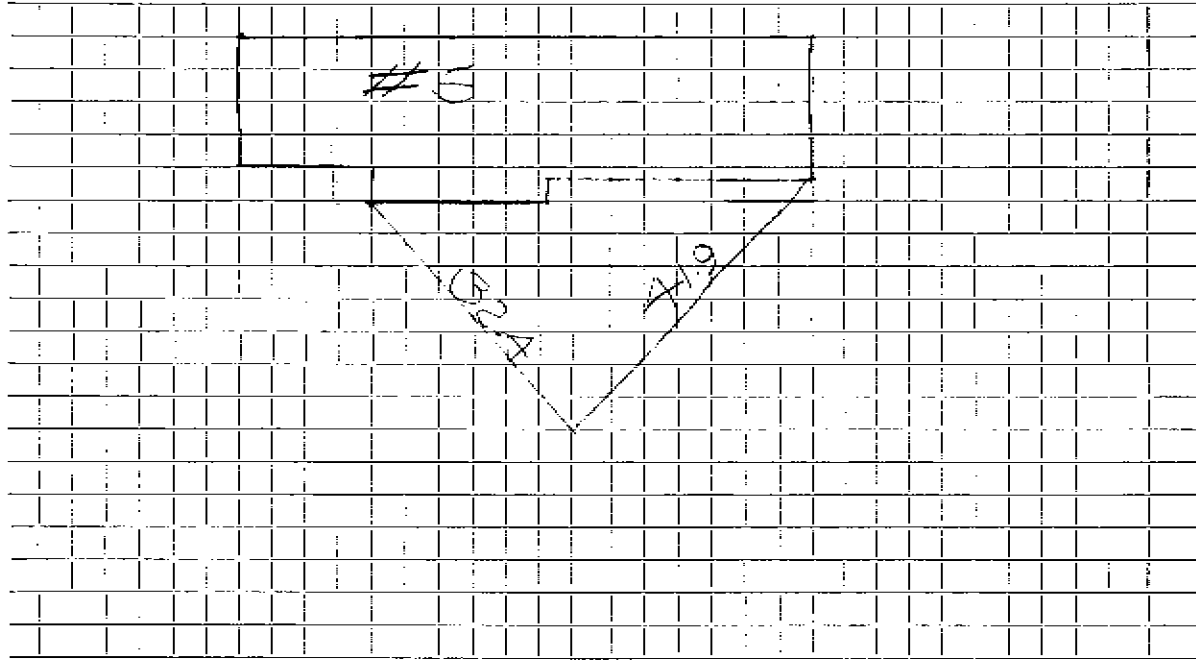

Connection made in Street. Work completed

Remarks:
.....
.....