

WATER SERVICE RECORD

2732

Name Mark Moore, Jr.

Service No. 98

Address 6 Essex Street

Location

~~Repair~~ ~~Renewal~~ - New Service


Date	Material	Amount	Total	Date	Amount	
5/14/56	Labor	1 95		5-14-56	Deposit	35 00
	10% overhead	20	2 15	8-6-56	Refund	11 14
	33' - 3/4" Copper tubing @ .4850	16 00			NON CHARGE	23 86
	1 - 3/4 Cx 1/2 I.W.H. Stop & Waste		4 96	5/14/56		
	1 hr. trucking		75	1 - 1/2	Straight tailpiece	50
			23 86	1 - 1/2	Offset tailpiece	50
						1 00
				Curb only		
	Service in to curb			9-8-55	NON CHARGE	
				10'	3/4" Copper Tubing	
				1	3/4 Curb Cock	
				1	3/4 Corp Cock	
				1	Box & Rod	

DATE _____

TOWN OF LEXINGTON — BOARD OF PUBLIC WORKS

WATER DIVISION

Sketch of Service Here

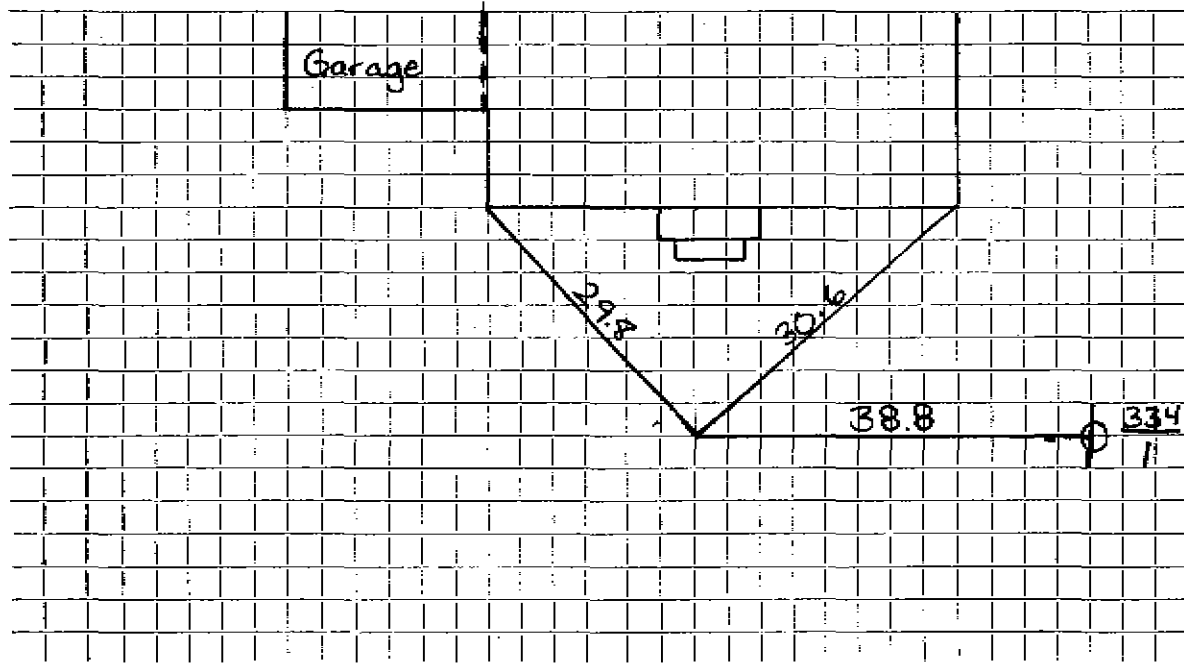

Connection made in Street. Work completed

Remarks:

.....

.....