

## WATER SERVICE RECORD

#5583

Name Mark Moore, Jr.

Service No. 99

Address 8 Essex Street

Location

~~Repair - Renewal~~ - New Service

Service in to curb


Date	Material	Amount	Total	Date	Amount
5/15/56	Labor	1 95		5-14-56 Deposit	\$ 35 00
	10% overhead	20	2 15	8-6-56 Refund	11 14
	33' - 3/4" Copper tubing @ .4850	16 00		NON CHARGE	23 86
	1 - 3/4Cx 1/2 I.W.H. Stop & Waste		4 96	5/15/56	
	1 hr. trucking		75	1 - 1/2 Straibht tailpiece	50
			23 86	1 - 1/2 Offset tailpiece	50
					1 00
				Curb only	NON CHARGE
				9-8-55 10' 3/4" Copper Tubing	
				1 3/4" Curb Cock	
				1 3/4" Corp Cock	
				1 Box & Rod	

DATE \_\_\_\_\_

TOWN OF LEXINGTON — BOARD OF PUBLIC WORKS

WATER DIVISION

Sketch of Service Here

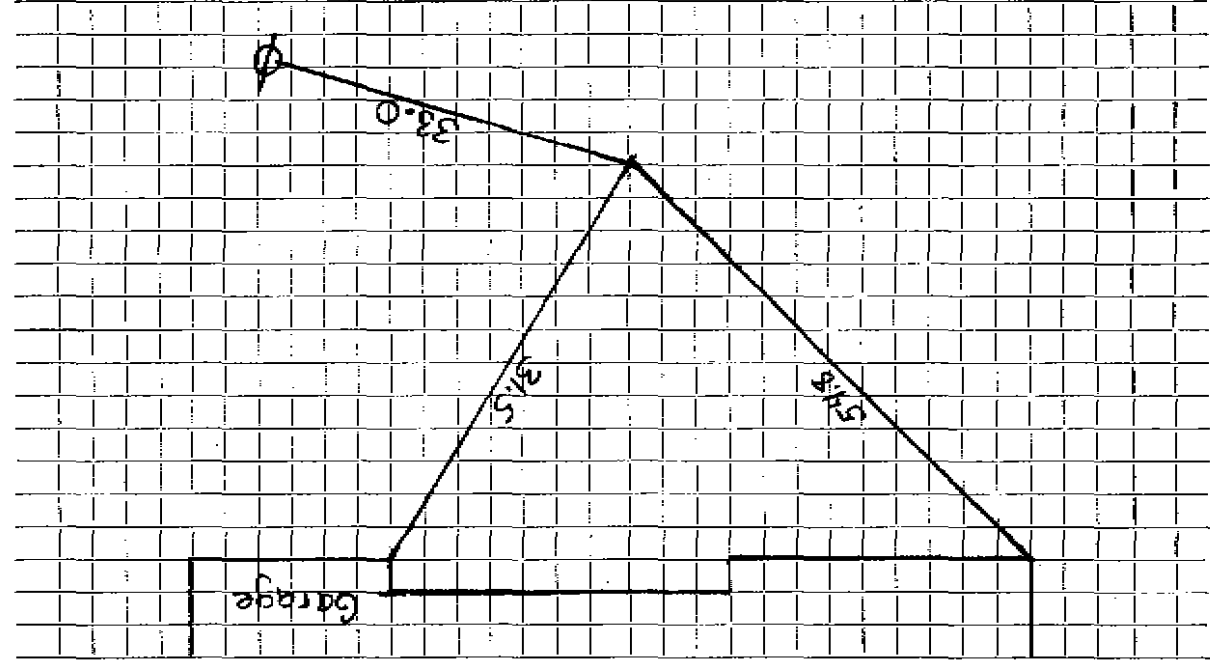

Connection made in \_\_\_\_\_ Street. \_\_\_\_\_ Work completed

Remarks: \_\_\_\_\_