

WATER SERVICE RECORD

Name John Cahill

Service No. 252

Address 14 Esterbrook Road

Location Lexington


~~Repair - Renewal~~ - New Service

Comm. 12-3-56

Date	Material	Amount	Total	Date	Amount
9/26/56	Labor	1 95		8-21-56	Deposit # 10 00
	10% Overhead	20	2 15	12-3-56	Refund 2 14
	1 - 3/4" I.W.H. stop&waste		4 96		<u>NON CHARGE</u> 7 86
	1 hr. trucking@.75		75	Labor	5 25
			7 86	30 3/4" copper tubing@.4850	14 55
				1 - 3/4" C. corp. cock	4 64
				1 - 3/4" C. curb-cock	5 94
				1 box and rod	4 62
	OWNERS COPPER			1 1/2 straight tail piece	50
				1 1/2 offset tail piece	50
					<u>36 00</u>

TOWN OF LEXINGTON — BOARD OF PUBLIC WORKS
WATER DIVISION

Sketch of Service Here

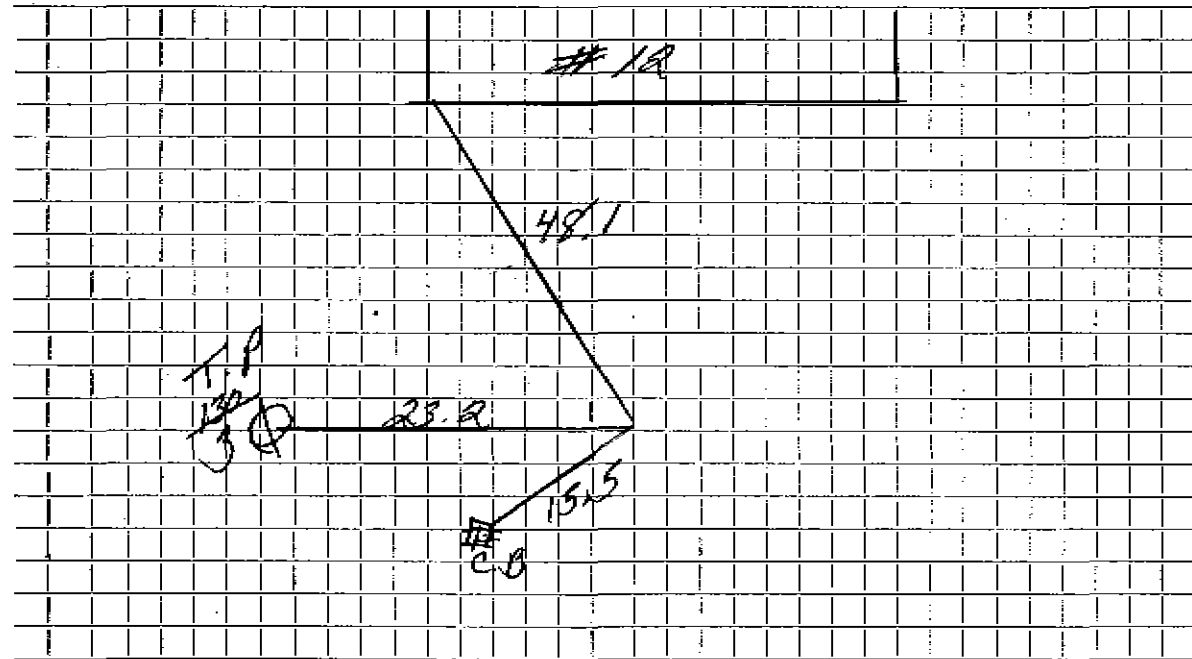

Connection made in Street. Work completed

Remarks:
.....
.....