

WATER SERVICE RECORD

Name John Cahill

Service No. 253

Address ~~26~~ Estabrook Road

Location 16

~~Repair Renewal~~ New Service

Comm. 10-29-56


Date	Material	Amount	Total	Date	Amount
8-21-56	Owners Copper			8-21-56	Deposit 10.00
	1 3/4" C x 1/8 I.W.H. Stop & Waste	4.96	4.96	10-29-56	Refund 5.04
					NON CHARGE 4.92
				8/21/56	3/4" Copper tubing 14.55
					1 3/4" C. Corp Cock 4.64
					1 3/4" " " " 5.94
					1 Box & Rod 4.62
					1 - 1/2 Straight tail piece .50
					1 - 1/2 Offset tail piece .50
					32.70

DATE _____

TOWN OF LEXINGTON — BOARD OF PUBLIC WORKS

WATER DIVISION

Sketch of Service Here

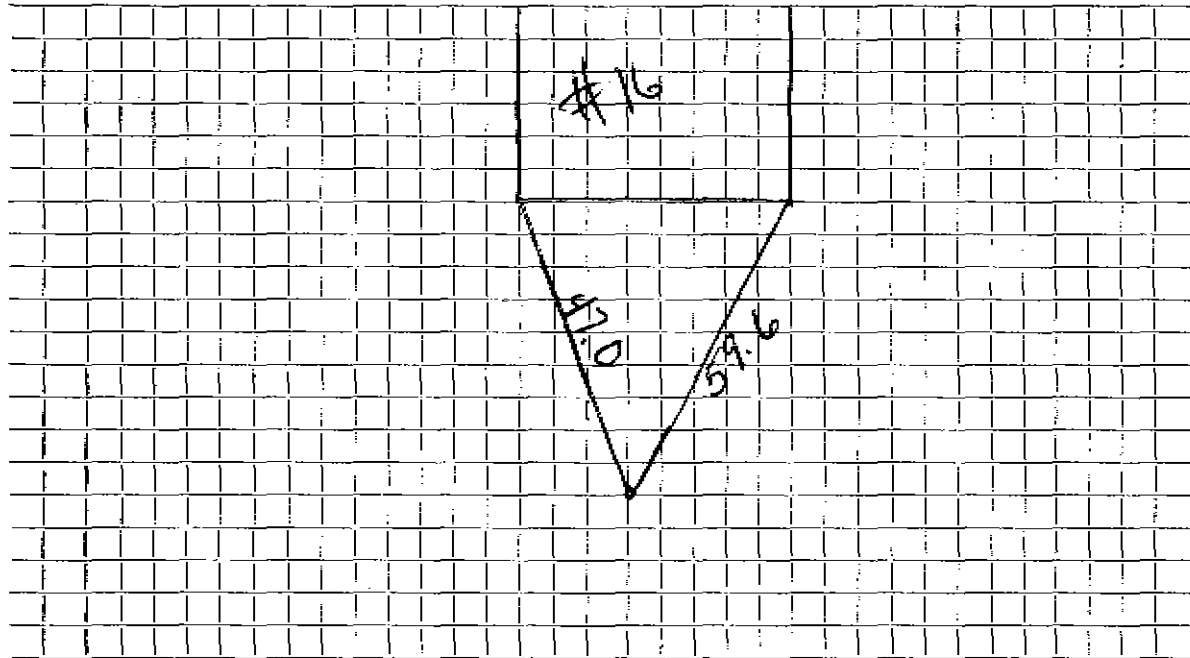

Connection made in Street. Work completed

Remarks:
.....
.....