

WATER SERVICE RECORD

Name Joseph E. Abbadessa

Service No. 85

Address 22 Estabroek Road

Location

Repair ~~Renewal~~ - New Service

Comm. 9/18/61


Date	Material	Amount	Total	Date	Amount
7/1/61	No Charge Labor	2 36			
	10% O.H.	24	2 60		
	1 3/4" CX 1/2 I.W.H. Stop & Waste	6 17	8 77		
	(Contractor Mcloy supplied copper)				
					No Charge
				7/1/61	30' 3/4" copper tubing @ .42 12 60
					1 3/4" C Corp Cock @ 4.91 4 91
					1 3/4" C Curb Cock @ 6.28 6 28
					1 Box & Rod @ 4.90 4 90
					1 1/2 Staight tail piece 50
					1 1/2 off set tail piece 50
					32 05

DATE \_\_\_\_\_

TOWN OF LEXINGTON — BOARD OF PUBLIC WORKS

WATER DIVISION

Sketch of Service Here

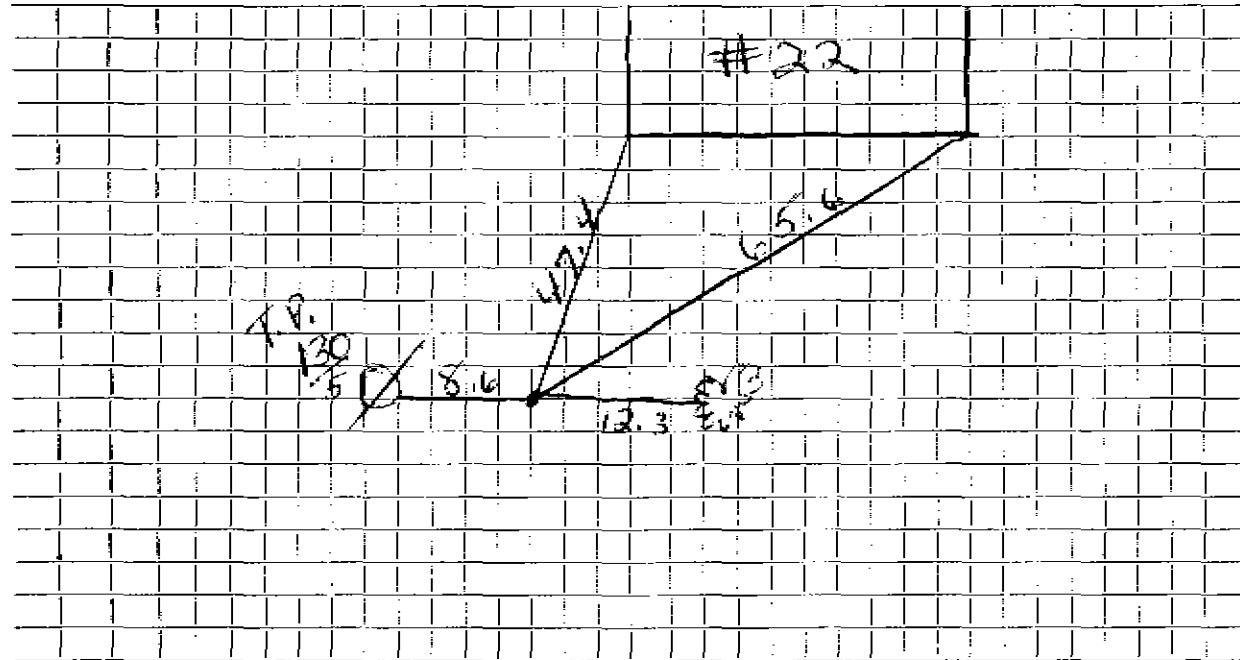

Connection made in ..... Street. Work completed .....

Remarks: .....

.....  
.....