

WATER SERVICE RECORD

Name Norman Peterson

Service No. 41

Address 30 Estabrook Raod

Location


~~Repair - Reconnect~~ - New Service WO #4705 DeFelice #2860

OCT 25 1976

Date	Material	Amount	Total	Date	Amount	
8/6/76	labor	44. 42		7-14-76	Deposit	100 00
	10%OH	4. 44	48. 86	11-17-76	Paid	14 12
32'	3/4" Copper @ .65		20. 80			114 13
2	1 1/2 nipples - 6" long @ 1.10		2. 20	5-22-90	4'-3/4 COPPER	
1	3/4" curb stop		13. 70	1	3/4 Comp Union	
2	1 1/2 style 38 @ 6.58		13. 16	1	3/4 CORP COMP	
1	curb box and rod		15. 40			
			114. 12			

TOWN OF LEXINGTON — BOARD OF PUBLIC WORKS  
WATER DIVISION

Sketch of Service Here

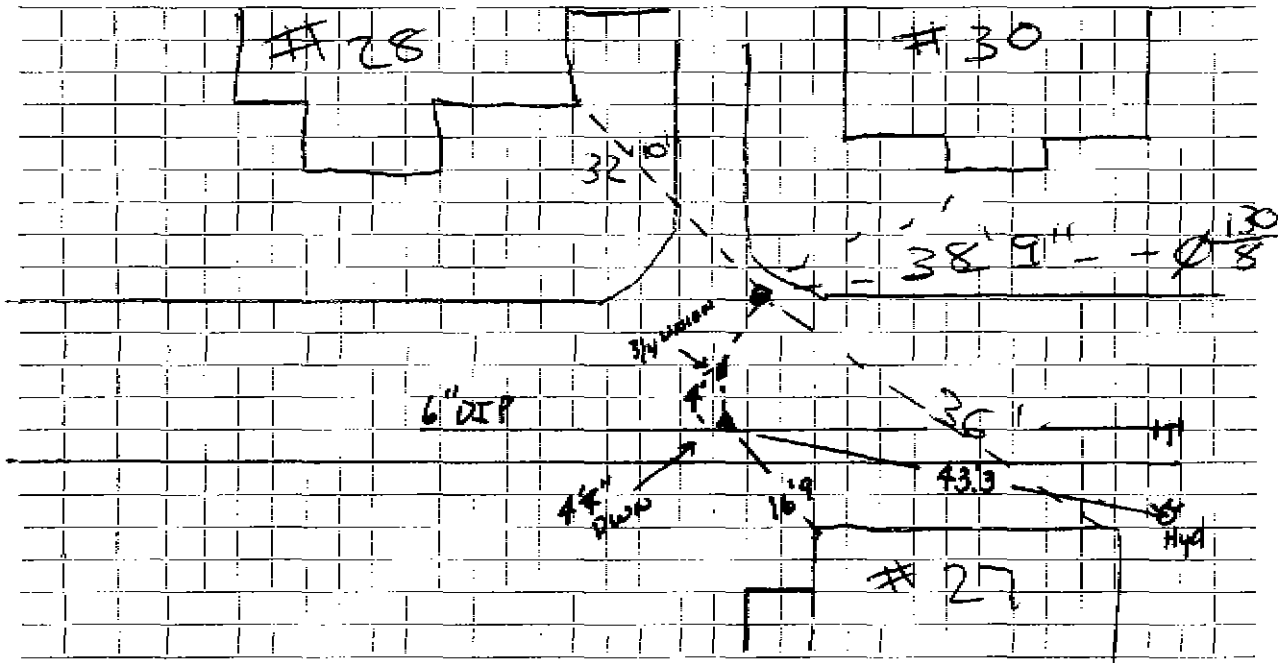

Connection made in ..... Street. Work completed .....

Remarks: .....  
.....  
.....