

## WATER SERVICE RECORD

Name Mrs. T. K. Norton

Service No. 128

Address 1 Eustis Street

# 939

Location

~~Repair~~ Renewal ~~New Service~~

Comm 11-13-61


Date	Material	Amount	Total	Date		Amount
9-12-61	Labor	72.37		9-11-61	Deposit	100.00
	10% O.H.	7.24	79.61	12-4-61	Paid	34.25
48'	3/4" Copper tubing @.42		20.16			1.34 38
1	3/4" C x 1" I, 2 part union		1.62		NON CHARGE	
1	1" G.L. Nipple		.72	1	1/2 Straight tailpiece	.50
1	3/4" C x 1/2 I.W.H. Stop & Waste		6.17			
4	hrs. Pippin Shovel @\$1.00		20.00			
2	hrs. Trucking @3.00		6.00			
			134.28			

DATE \_\_\_\_\_

TOWN OF LEXINGTON — BOARD OF PUBLIC WORKS

**WATER DIVISION**

Sketch of Service Here

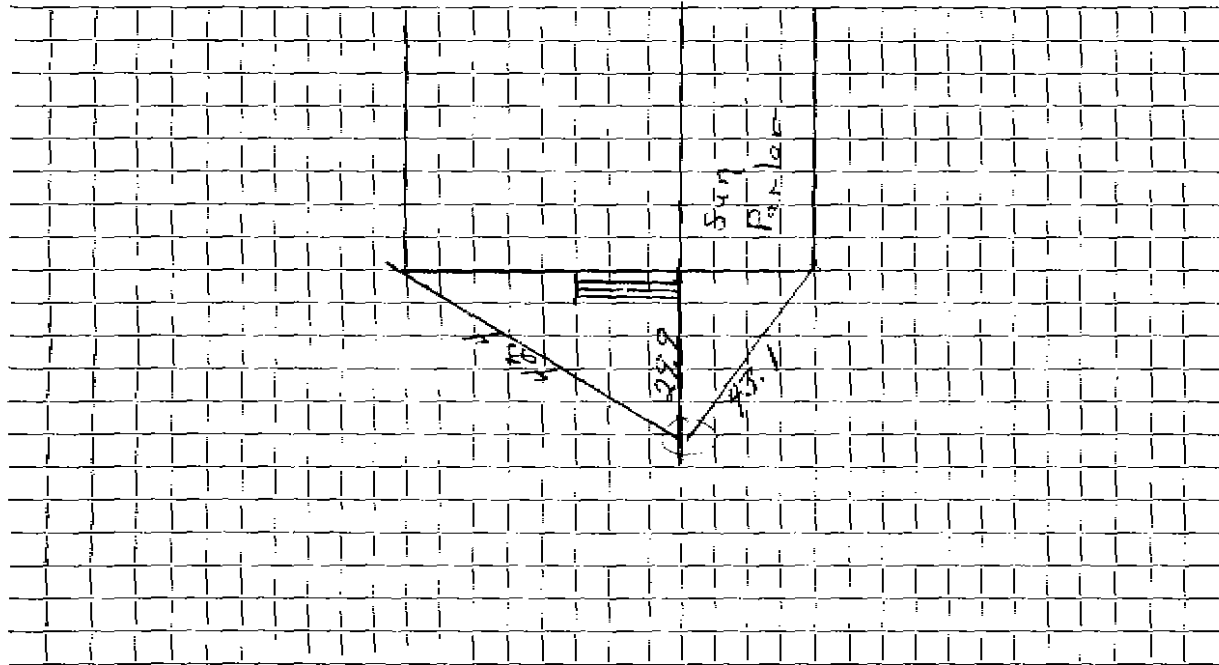

Connection made in East 15 St. Street. Work completed .....

Remarks: copy from old card .....

.....  
.....




DATE \_\_\_\_\_

TOWN OF LEXINGTON — BOARD OF PUBLIC WORKS

WATER DIVISION

Sketch of Service Here

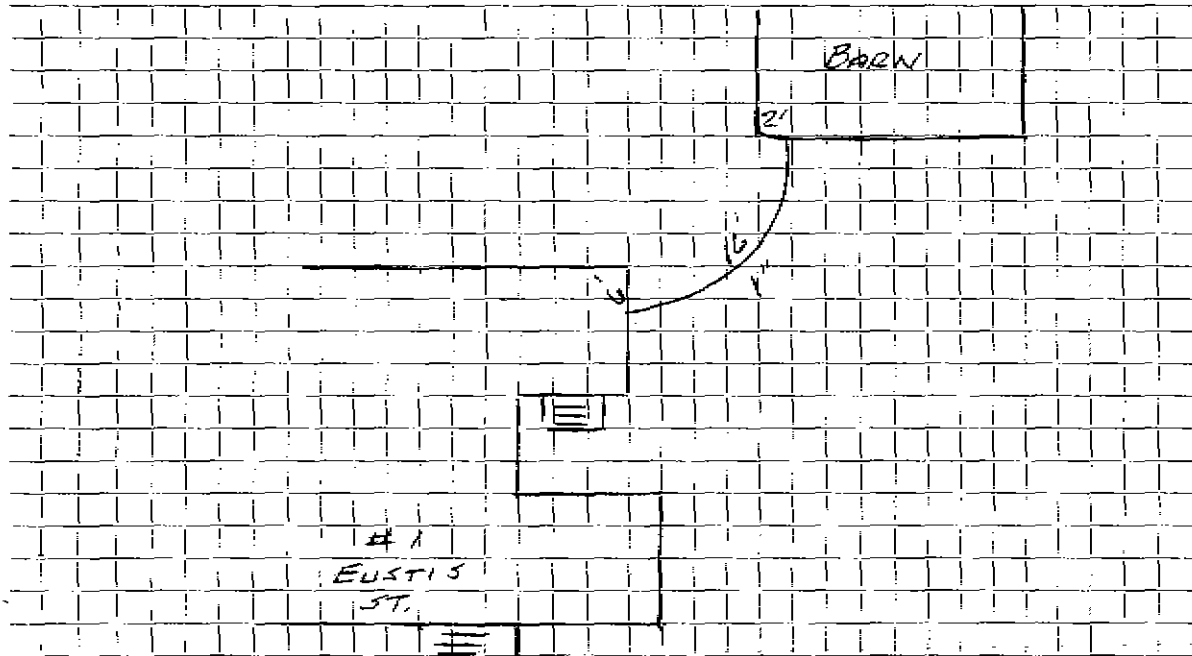

Connection made in HOUSE TO BARN Street. Work completed .....

Remarks: .....  
.....  
.....