

## WATER SERVICE RECORD

Service No. 94

Name John D. Trenholm

Address 2 Eustis Street

Location

~~Repair~~ - Renewal - ~~New Service~~

Conn. 6-1-54


Date	Material	Amount	Total	Date	Amount
4/23/54	Labor	63.47		4-23-54	Deposited 100.00
	10% Overhead	6.35	69.82	6-1-54	Refunded 6.18
	55' 3/4" Copper Tubing @ .35	19.25			NON CHARGE 93.82
	1 - 3/4" Cx 1/2" I.W.H. stop & waste	4.00		4/23/54	Labor
	1 Hr. Trucking		75	4/25/54	Labor
			93.82		
					30' 3/4" Copper Tubing @ .35
					1 - 3/4" C. Corp-cock
					1 - 3/4 Cx 3/4" C. Curb-cock
					1 Box & Rod
					1 - 1/2" Straight Tail Piece
					1 - 1/2" offset tail piece
					2 2/3 Hrs. Littlefield Shvl. @ 7.50
					1 Hr. Trucking
					Patching 27x3
					171.93

DATE \_\_\_\_\_

TOWN OF LEXINGTON — BOARD OF PUBLIC WORKS

**WATER DIVISION**

Sketch of Service Here

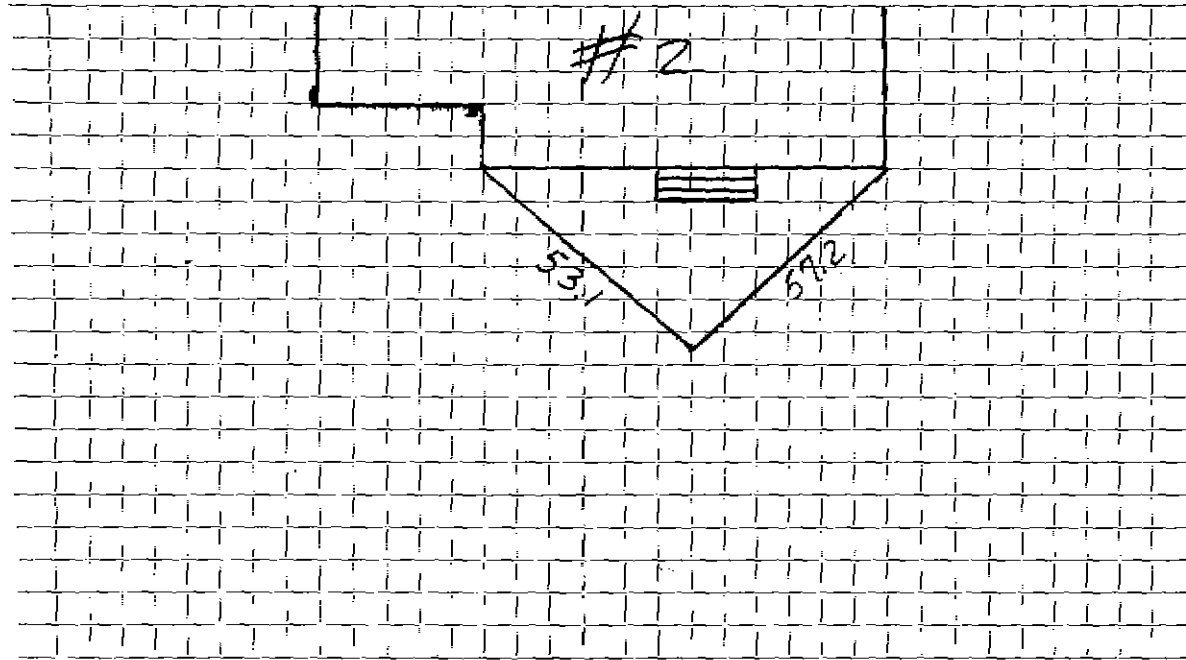

Connection made in ..... Street. Work completed .....

Remarks: .....  
.....  
.....