

WATER SERVICE RECORD

6267

Name William Weems

Service No. 387

Address 4 Eustis Street

Location

~~Repair~~ - ~~Renewal~~ - ~~New Service~~

Comm. 4/1/57

Date	Material	Amount	Total	Date	Amount
12/27/56	La bor	50 40		12-26-56	Deposit \$ 100 00
	10% overhead	5 04	55 44	5-24-57	Paid 7 03
	60' - 3/4" Copper tubing @ .4396		26 38		\$ 107 03
	1 - 3/4" Cx 1/2 I.W. H. Stop & Waste		4 96		NON CHARGE
	1 hr. trucking		75	28' - 3/4" Copper tubing @ .4396	12 31
	3 hrs. Town Shovel @ 6.50		19 50	1 - 3/4" C. Corp Cock	4 64
			107 03	1 - 3/4" C. Curb Cock	5 94
				1 Box & Rod	4 62
				1 - 1/2" Straight tailpiece	50
				1 - 1/2" Offset tailpiece	50
					52 21


Bill sent 4/3/57

DATE _____

TOWN OF LEXINGTON — BOARD OF PUBLIC WORKS

WATER DIVISION

Sketch of Service Here

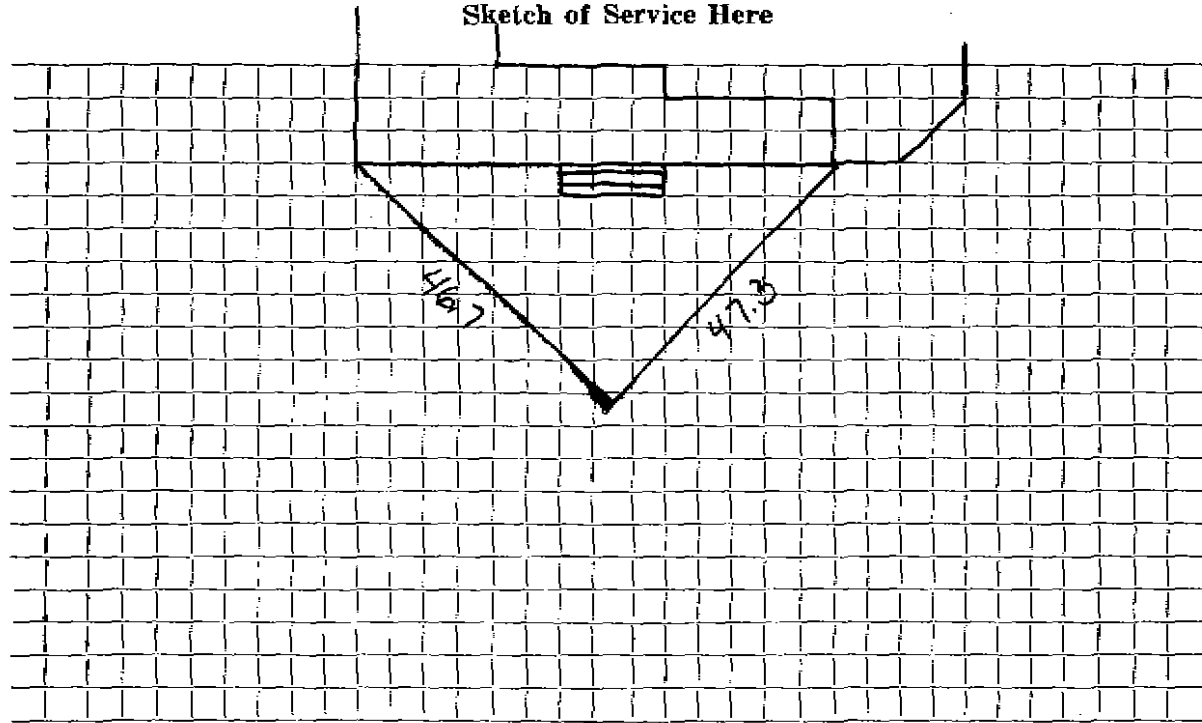

Connection made in Street. Work completed

Remarks:

.....

.....