

WATER SERVICE RECORD

1444

Name Olive Thompson

Service No. 73

Address ~~XXXXXXXXXXXX~~ 12 Evergreen Lane

~~674~~

Location

7238

Repair ~~Repair~~ ~~New Service~~

WO # 2352

Comm 12-1-62


Date	Material	Amount	Total	Date	Amount
6/15/62	Labor	31 02		6-15-62	75 60
	10% O.H.	3 10	34 12	6-1-62	8 63
	24' 3/4" Copper Tubing @ .42		10 08		66 37
	1 3/4" Cr $\frac{1}{2}$ IWH Stop & Waste		6 17		
	2 Hrs. Town Shovel @ 6.50		13 00		NON CHARGE
	1 Hr. Trucking @ 3.00		3 00	5-11-62	Labor 21 48
			66 37		1 3/4" Style 38 Coupling 3 43
					1 hr. Town Shovel @ 6.50 6 50
					1 hr. Trucking @ 3.00 3 00
					34 41
					1 $\frac{1}{2}$ Straight Tailpiece 50
					1 $\frac{1}{2}$ Offset Tailpiece 50
					<u>35 41</u>

DATE _____

TOWN OF LEXINGTON — BOARD OF PUBLIC WORKS

WATER DIVISION

Sketch of Service Here

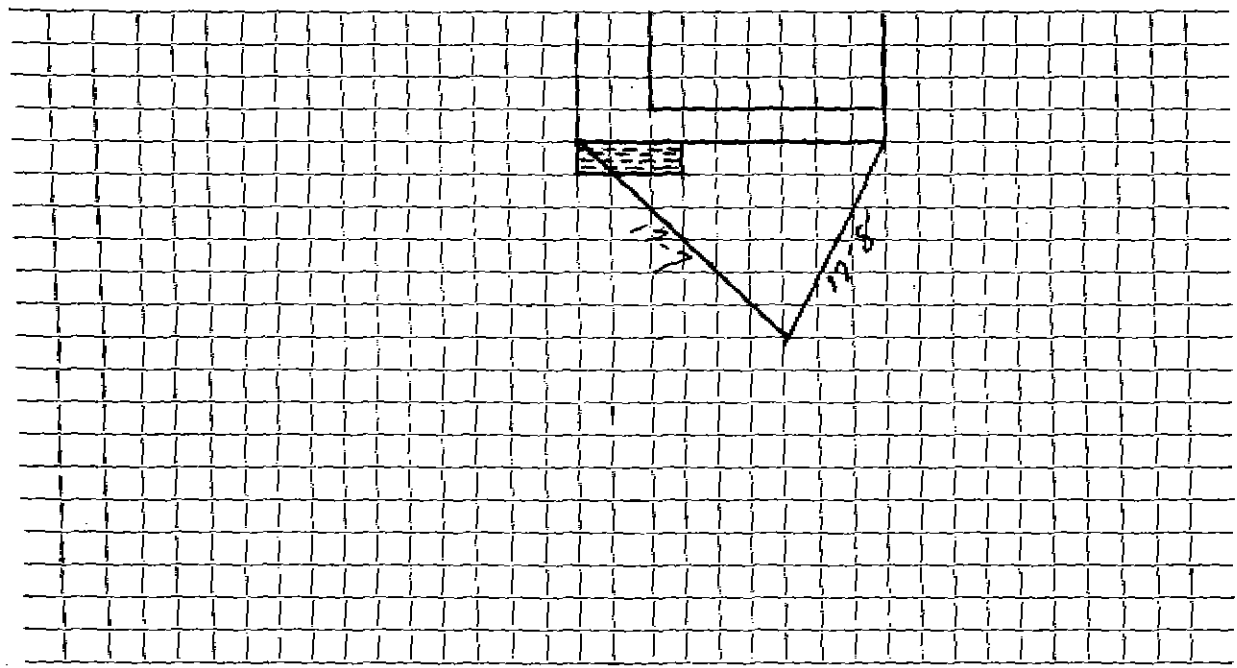

Connection made in Street. Work completed

Remarks:
.....
.....