

WATER SERVICE RECORD

Name Richard T. Macdonald

Service No. 370

Address ~~100 Franklin Ave.~~ 18 Evergreen Lane

Location Lexington

Repair ~~Renewal~~ ~~New Service~~

Com. 11-30-53
TRENCH DUG BY OWNER


Date	Material	Amount	Total	Date	Amount
11/19/53	Labor	4 75		11-16-53	<i>Deposited</i> 25 00
	10% overhead	18	1 93	11-30-53	<i>Refunded</i> 7 43
	30'-3/4" Copper tubing @.3629	10 89			NON CHARGE 17 57
	1-3/4" C x 1/2 I.W.H. STOP & WASTE	4 00		11/17/53	Labor 12 64
	1 Hr. Trucking		75	11/18/53	Labor 19 00
			17 57	11/19/53	Labor 20 42
					6'-3/4" Copper tubing @.3629 2 18
					1-3/4" C. Corp-cock 4 33
					1-3/4" C x 3/4" C. Curb-cock 4 67
					1-Box & Rod 3 00
					1-1/2 offset tail piece 50
					1-1/2 straight tail piece 50
					3 2/3 Hr. Littlefield shovel @7.50 27 50
					1 Hr. Trucking 75
					<u>96 39</u>

DATE _____

TOWN OF LEXINGTON — BOARD OF PUBLIC WORKS

WATER DIVISION

Sketch of Service Here

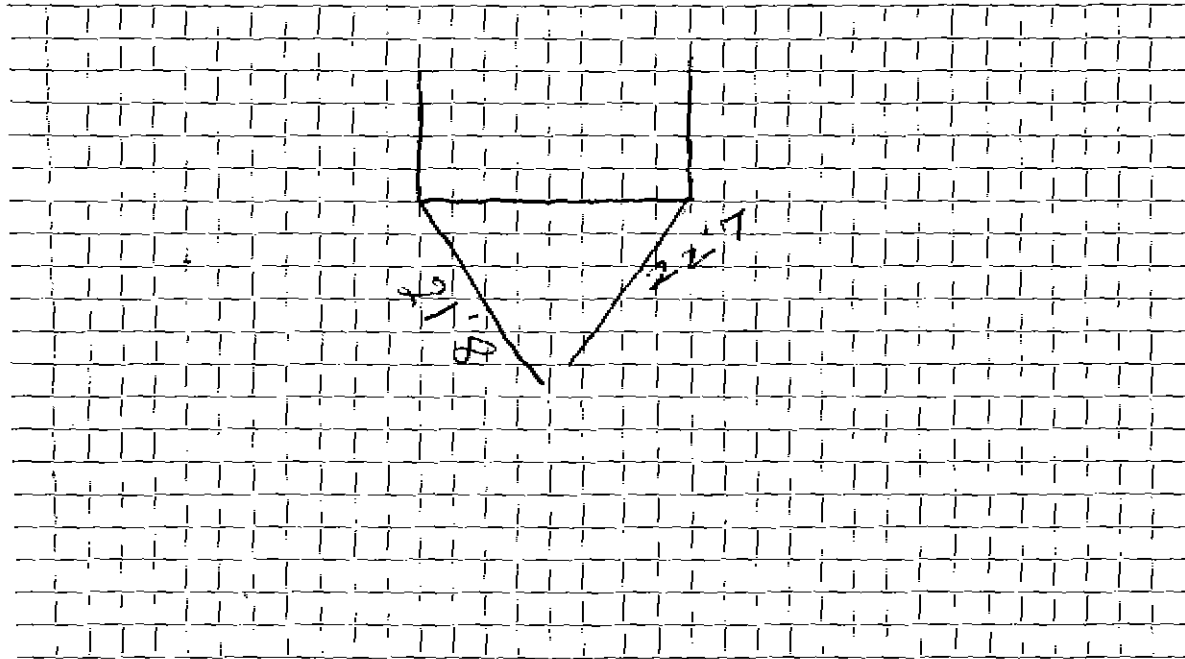

Connection made in Street. Work completed

Remarks:

.....

.....