

Name Max Frederick Selfridge, Builder
 12 Pine Court, Arlington
 Address 38. Aberdeen Rd., Somerville

Service No. ~~84~~ 984
 #6413

Location ~~12 Pine Court~~ 3 Evergreen Lane

Kind of Pipe Size Size of Main

Repair—Renewal—New Service Location

Date	Material	Amount	Total	Date	Amount
36	1" C.L. Pipe @.27	9 72		<i>July 24 1925 - Cash</i>	50 00
2	1" L.L. Ells @.35	70			
2	1" L.L. Coup. @.25	50			
1	1" Br. St. Nipple	25			
1	S & W Trucking	3 00 75	14 92		
8/10/28	28 Hrs. Labor @.55	15 40			
2	" " @.60	1 20	16 60		
	15% Overhead		2 49		
			34 01		
<i>October 20</i>	<i>Labor 19 28 - Return</i>		15 99		
			17 00		

Madley Press, Inc. Lexington

DATE July 24, 1928

TOWN OF LEXINGTON—BOARD OF PUBLIC WORKS
WATER DIVISION

The undersigned applies for a supply of water at No. H³ Franklin Ave St. and hereby agrees to comply with the rules and regulations as now, or at any future time, established by the Board of Selectmen.

Am't. of Estimate \$ _____

Owner

Max Friedrich


Am't. Paid \$ 57.⁰⁰ 7/24/28

Address

38 Aberdeen Road
Somerville

Builder B.J. Selbridge
12 Pine Street Lexington

Sketch of Service Here

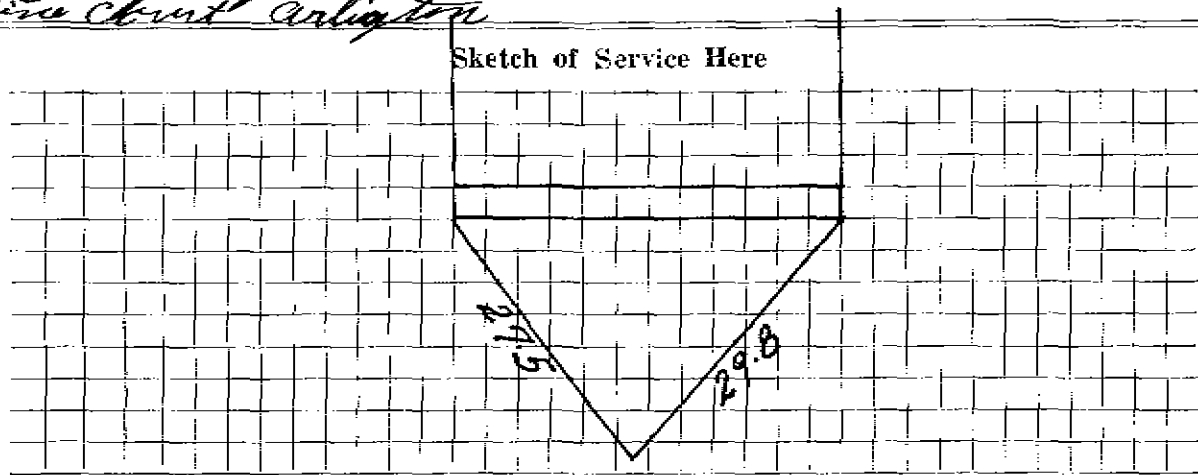

Connection made in _____ Street. Work completed _____ 19

Remarks: