

WATER SERVICE RECORD

Name Benedict Mochello

Service No. 53

Address 5 Evergreen Lane

Location

~~Repair~~ - New Service W.O. #3014

OCT 3 1966

Date	Material	Amount	Total	Date	Amount
8-24-66	Labor	5 61		8-5-66	50 00
	10% O.H.	56	6 17	11-3-66	7 73
31'	3/4" copper tubing @ .88		27 28		57 73
1	Box & Rod		5 10		
1	3/4" Curb Cock		8 76		
1	3/4" Corp. Cock		7 42		
1	Hr. Trucking		3 00		
			57 73		


Deposit
Paid by SHC # 10-3

DATE _____

TOWN OF LEXINGTON — BOARD OF PUBLIC WORKS

WATER DIVISION

Sketch of Service Here

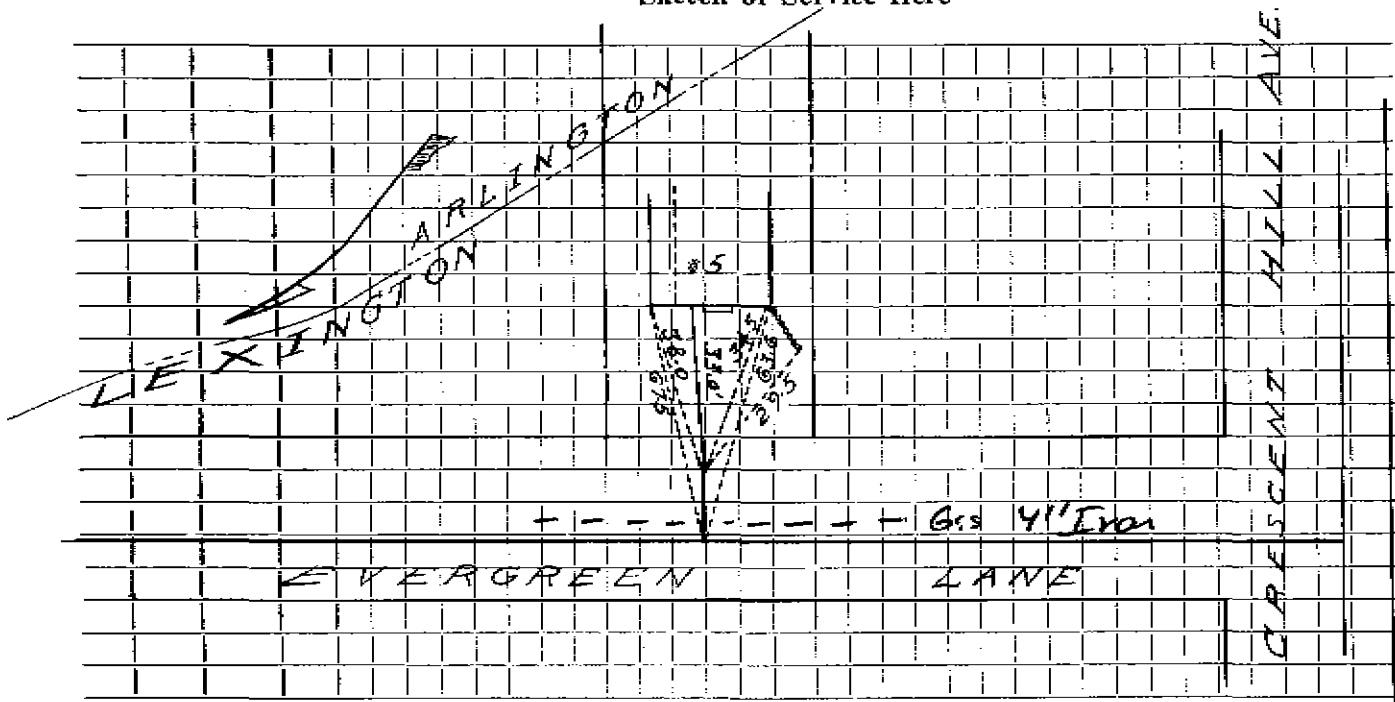

Connection made in _____ Street. Work completed _____

Remarks: G.S. 18" from water 3' deep Water about 4'

.....
.....