

WATER SERVICE RECORD

Name

Service No.

Address 6 Evergreen Lane

Location

Repair—Renewal—New Service


Date	Material	Amount	Total	Date	Amount
12/27/84	7' 3/4" Copper			12-10-84	INSIDE
	1 Small 3/4 Copper Corp Adapter				OWNER INSTALLED OWN COPPER
	1 3/4" Curb				THIS SERVICE WAS NOT
	1 1" Copper to Iron Adaptor				APPROVED BY TOWN - WAS
	1 Curb Box & Rod				NOT ONLY 2' DEEP
	6 Yds. Gravel				1" COPPER INSIDE
	1 Ton Cold Patch				
	30 hrs. Labor				

DATE _____

TOWN OF LEXINGTON — BOARD OF PUBLIC WORKS

WATER DIVISION

Sketch of Service Here

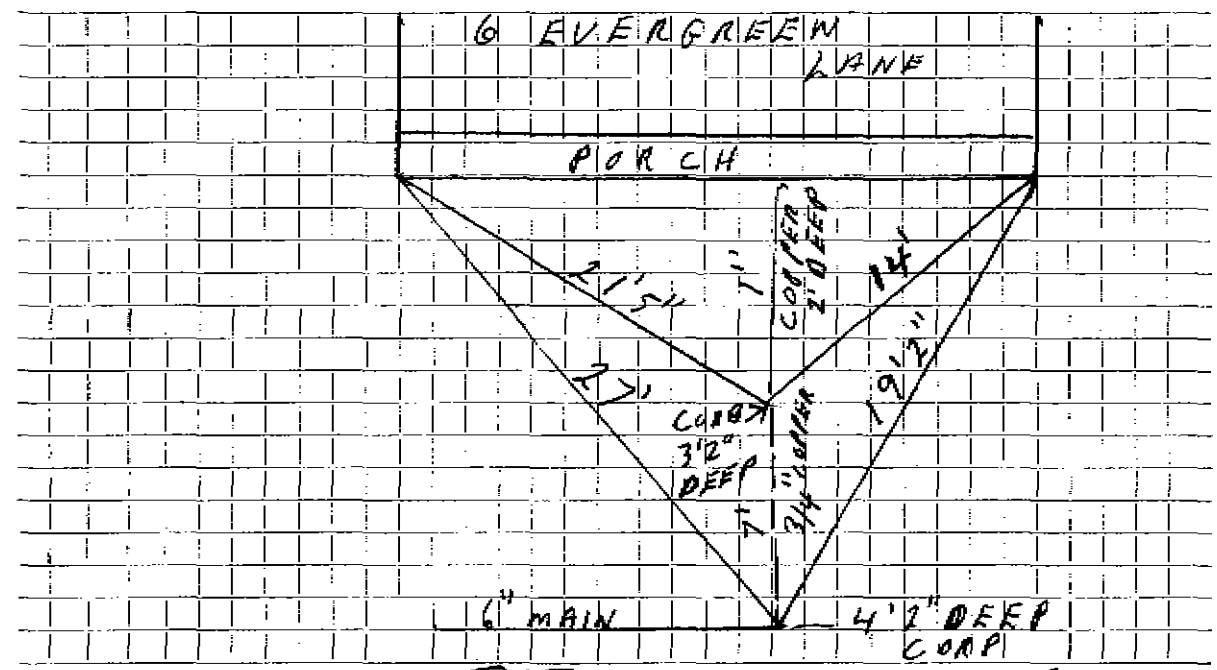

Connection made in _____ Street. Work completed _____ GAS 4" Iron

Remarks: GAS 18" from water 3' deep