

WATER SERVICE RECORD

Name **Four Seasons Construction Corp**

Service No. **31**

Address **7 Evergreen Lane**

Location

Reason for work **New Service**

W.O. # **7953**

1927 Sibley
1926 11/21

SEP 21 1970

Date	Material	Amount	Total	Date	Amount
7/28/70	Labor	90 90		7-28-70	146 60
	10% O.H.	9 09	99 99	7-28-70	33 52
40'	3/4" Copper pipe	.79	31 60		173 57
	3/4" Corporation		2 76		
	3/4" Curb stop		11 32		
	Box & Rod		5 10		
3	Hrs. Shovel	6.50	19 50		
1	Hr. Trucking		3 00		
			173 27		
10-27-71	33' 3/4" Copper tubing				


✓

DATE _____

TOWN OF LEXINGTON — BOARD OF PUBLIC WORKS

WATER DIVISION

Sketch of Service Here

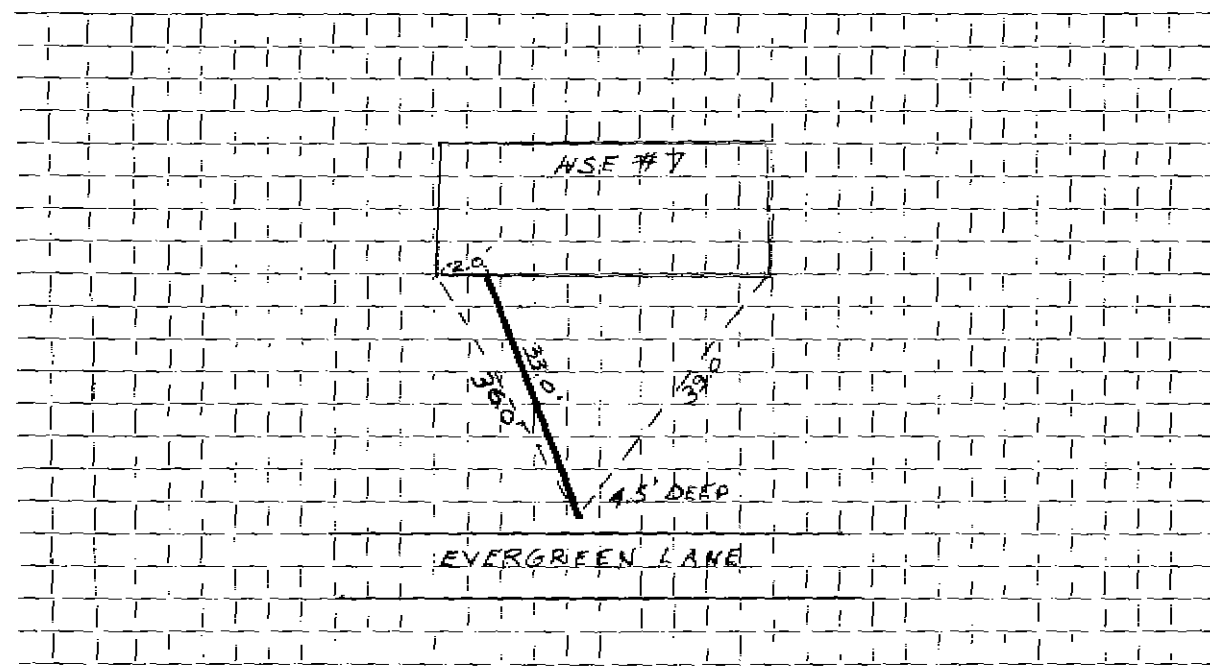

Connection made in Street. Work completed

Remarks:
.....
.....