

WATER SERVICE RECORD

2376  
Service No. 734

Name Hugh T. Clark

Address 1 Whell Lane

Location Com. F-30-54


~~Repair~~ ~~Renewal~~  New Service SERVICE WAS IN TO CURB:

Date	Material	Amount	Total	Date	Amount
7/21/54	Labor	2 00		6-14-54 Deposited	25 00
	10% Overhead	20	2 20	F-30-54 Paid	( 1 20
	55' - 3/4" Copper Tubing @ .35		19 25		26 20
	3-3/4" C x 1/2" C.W.F. stops waste		4 00	7/21/54 (Service into Curb.)	
	1 Hr. Trucking		75	3-1/2" Straight Tail Piece	50
			26 20	2-1/2" Offset Tail Piece	50
					2 00

DATE \_\_\_\_\_

TOWN OF LEXINGTON — BOARD OF PUBLIC WORKS  
WATER DIVISION

Sketch of Service Here

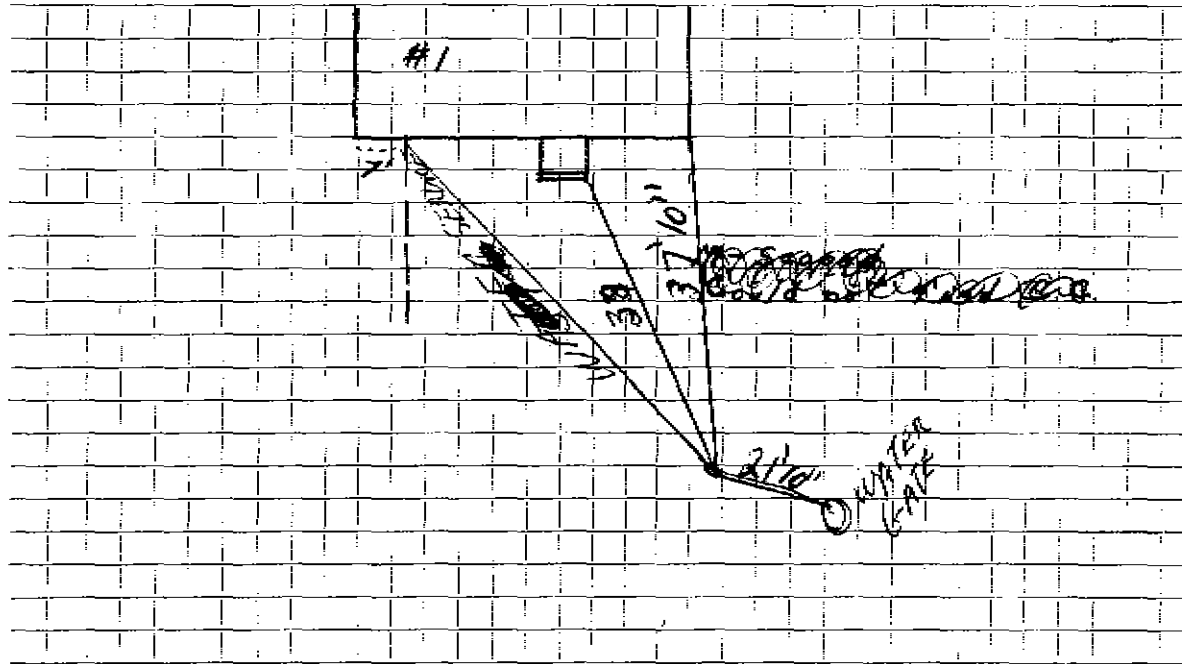

Connection made in ..... Street. Work completed .....

Remarks: .....  
.....  
.....