

WATER SERVICE RECORD

Name DeVries Const. Co.

Service No. 343

Address 10 Ewell Ave.

Location Lexington

~~Repair~~ ~~Renewal~~ New Service

TRENCH DUG BY OWNER

Com. 11-30-53


Date	Material	Amount	Total	Date	Amount
11/19/53	Labor	1 75		11-22-53	20 00
	10% overhead	18	1 93	12-14-53	1 83
	37'-3/4" Copper tubing @.3629	13 43			21 83
	1-3/4" C x 1/2 I.W.H. STOP & WASTE	4 00			
	1-3/4" C x 3/4" C. Union(3parts)	1 72		11/19/53	2 59
	1 Hr. Trucking	75		30'-3/4" Copper tubing @.3629	10 89
			21 83	1-3/4" C. Corp-cock	4 33
				1-3/4" C x 3/4" C. Curb-cock	4 67
				1-Box & Rod	3 90
				1-1/2 straight tail piece	50
				1-1/2 offset tail piece	50
				1 Hr. Trucking	75
					28 13

DATE _____

TOWN OF LEXINGTON — BOARD OF PUBLIC WORKS

WATER DIVISION

Sketch of Service Here

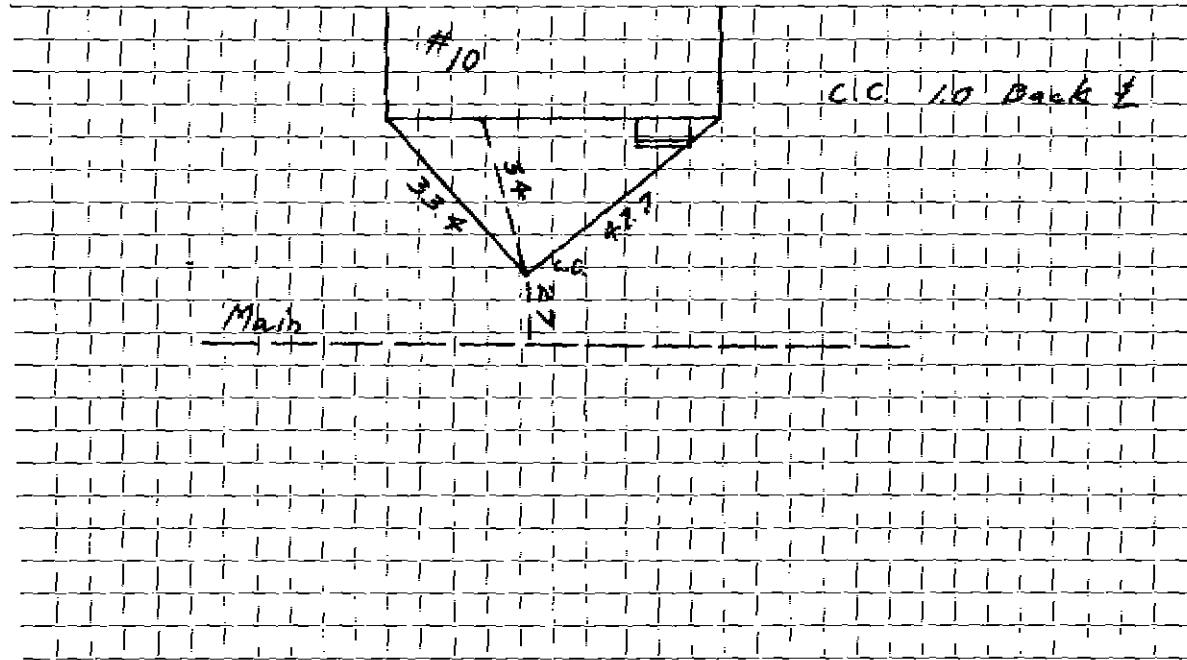

Connection made in Street. Work completed

Remarks:
.....
.....